

For corners in

Presque Isle  
(County)

Located In:

Corner Code #

1. Public Land Survey

T34NR 5E

M-8

T R

T R

T R

T R

2. Property Controlling  
in Section

S

T R

S

T R

3. Miscellaneous  
Property in Sec.

S

T R

S

T R

*Jane M. Starn*  
REGISTER OF DEEDS

SURVEY &  
REMONUMENTATION

JAN 14 1998

SECTION  
Register of Deeds Stamp & File Number

4. Lot No. \_\_\_\_\_, Recorded Plat \_\_\_\_\_  
5. Private Claims \_\_\_\_\_

I, Delmer E. Porter in a field survey on 3-27, 1997 do hereby state that under requirements of P.A. 74, Michigan P.A. of 1970, the corner points mentioned in lines 1 and 2 above were in conformance with regulations and rules therefore as required in the current manual of survey instructions of the United States Department of the Interior, Bureau of Land Management or by a decree of a Court of Law and/or that the corner points mentioned in lines 3, 4 and 5 above were in conformance with the rules of the Michigan Board of Land Surveyors or by a Decree of a Court of Law; established, re-established, monumented, recovered, found as expressed below:

NOTE: Not more than 2 corners, all in the same town and range, may be recorded on this certificate.

	A	B	C	D	E	F	G	H	I	J	K	L	M
1													
2	6		5		4		3		2		1		
3													
4	7		8		9		10		11		12		
5													
6	18		17		16		15		14		13		
7													
8	19		20		21		22		23		24		
9													
10	30		29		28		27		26		25		
11													
12	31		32		33		34		35		36		
13													

A. Description of original monument and accessories and/or subsequent restoration:

M-8

GLO Notes

Alfred Millard  
July 5, 1856

Set. Qr. Sec. Post  
Hemlock 15" S80° E 19 Lk  
Sugar 24" N75° W 5 Lk  
Old Qr. Cor 6.17 S &  
227 W - effaced

R. Bischer #22428  
Act 74 Filing  
Dec. 28, 1982  
L. 1 Pg. 593

Set 1/2" Rod From  
Fence Corner  
N68° W 17.73' 5" Maple  
N23° W 21.39' 11" Maple  
N58° E 42.00' 6" Apple

B. Description of corner evidence found and/or method applied in restoring or reestablishing corner:

M-8

Fd. 1/2" Rod & Cap #15410 in E-W FE Line  
30' East of Cattle FE Cor.  
N62° E 42.36' 9" Apple  
N22° W 21.42' 14" Apple  
N67° W 17.63' 8" Maple


Ratified by Peer Group  
in accordance with P.A. 345

Chairman *Delmer E. Porter*  
Date 12/18/97

C. Description of monument for corner and accessories established to perpetuate locating the position of the corner:

M-8

1/2" Rod & Cap #15410 in E-W FE Line  
30' East of Cattle FE Cor.  
N62° E 42.36' 9" Apple  
N22° W 21.42' 14" Apple  
N67° W 17.63' 8" Maple  
N11° E 55.34' 12" Aspen

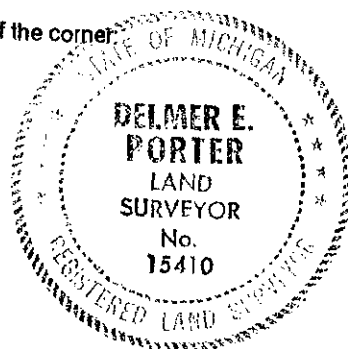

Signed by *Delmer E. Porter*  
Surveyor's Michigan License No. 15410

Date 12/18/97