

For corners in

Located In:

Corner Code ~~77~~

- | | | | |
|---------------------------------------|-----|------------|----|
| 1. Public Land Survey | T | R | |
| | T | R | |
| | T | R | |
| | T | R | |
| 2. Property Controlling
in Section | S 9 | T 35N R 3E | 12 |
| | S 9 | T 35N R 3E | 13 |
| 3. Miscellaneous
Property in Sec. | S | T | R |
| | S | T | R |

Register of Deeds Stamp & File Number

4. Lot No. _____, Recorded Plat _____
5. Private Claims _____

I, Carl R. Johnson, in a field survey on December 5, 1990, do hereby certify that under requirements of P.A. 74, Michigan P.A. of 1970, the corner points mentioned in lines 1 and 2 above were in conformance with regulations and rules therefore as required in the current manual of survey instructions of the United States Department of the Interior, Bureau of Land Management or by a decree of a Court of Law and/or that the corner points mentioned in lines 3, 4 and 5 above were in conformance with the rules of the Michigan Board of Land Surveyors or by a Decree of a Court of Law; established, re-established, monumented, re-monumented, recovered, found as expressed below:

NOTE: Not more than 4 corners, all in the same town and range, may be recorded on this certificate.

[illegible]

A. Description of original monument and accessories and/or subsequent restoration:

B. Description of corner evidence found and/or method applied in restoring or reestablishing corner:

- 12 - Found monument in place from a previous section subdivision survey.
13 - Set by standard survey procedure for subdivision of a section.

C. Description of monument for corner and accessories established to perpetuate locating the position of the corner:

- 12 - Found $\frac{1}{2}$ " iron rerod Sl/8 Post on N & S
 $\frac{1}{4}$ line Sec. 9


- 13 - Set 5/8" iron rerod w/cap center
of SE $\frac{1}{4}$ Sec. 9

- J. Pine 4" N3°W 23.8 ft
Cherry 10" N50°E 45.2 ft
Cherry 12" S84°E 19.8 ft
Fence Corner Post S17°W 71.4 ft
Nail & Brass Tags

- W. Pine 5" S37°E 69.05 ft
J. Pine 8" S06°W 65.85 ft
J. Pine 10" N60°W 20.2 ft
J. Pine 14" N78°E 48.9 ft
Nails & Brass Tags

Signed by Carl Johnson
Surveyor's Michigan License No. 30013

Date 1/14/91

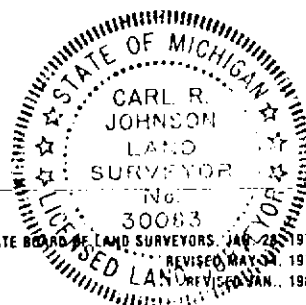

FORM APPROVED BY MICHIGAN STATE BOARD OF LAND SURVEYORS, JAN. 28, 1977
REVISED MAY 21, 1977
REVISED JAN. 1988