

1995 STATE OF MICHIGAN REMONUMENTATION

COMMISSION

LAND CORNER RECORDATION CERTIFICATE
Filing Requirement of Act 74, Mich. P.A. 1970

RESQUE ISLE COUNTY
RECORDED

DEC 14 AM 10:29

For corners in

Presque Isle
(County)

Located In:

Corner Code #

36N 2E

G4

- 1. Public Land Survey T 36N R 2E
- T _____ R _____
- T _____ R _____
- T _____ R _____
- 2. Property Controlling S _____ T _____ R _____
- in Section S _____ T _____ R _____
- 3. Miscellaneous S _____ T _____ R _____
- Property in Sec. S _____ T _____ R _____

Janet M. Lamb
REGISTER OF DEEDS

LIBER 316 PAGE 942

Register of Deeds Stamp & File Number

- 4. Lot No. _____, Recorded Plat _____
- 5. Private Claims _____

I, James A. Beck in a field survey on Nov. 3, 19 95, do hereby certify that under requirements of P.A. 74, Michigan P.A. of 1970, the corner points mentioned in lines 1 and 2 above were in conformance with regulations and rules therefore as required in the current manual of survey instructions of the United States Department of the Interior, Bureau of Land Management or by a decree of a Court of Law and/or that the corner points mentioned in lines 3, 4 and 5 above were in conformance with the rules of the Michigan Board of Land Surveyors or by a Decree of a Court of Law; established, re-established, monumented, re-monumented, recovered, found as expressed below:

	A	B	C	D	E	F	G	H	I	J	K	L	M
2	6		5		4		3		2		1		
3													
4	7		8		9		10		11		12		
5													
6	18		17		16		15		14		13		
7													
8	19		20		21		22		23		24		
9													
10	30		29		28		27		26		25		
11													
12	31		32		33		34		35		36		
13													

NOTE: Not more than 4 corners, all in the same town and range, may be recorded on this certificate.

A. Description of original monument and accessories and/or subsequent restoration:


G4 1856:
Government Resurvey
* by Geo. H. Cannon

Set post and referenced:
W. Ash 9" N20°W 14 Links
Y. Birch 7" S45°E 28 1/2 Links

B. Description of corner evidence found and/or method applied in restoring or reestablishing corner:

G4 November 3, 1995
Remonumentation by
James A. Beck P.S. 21559

No evidence found of original monument or accessories.
Set 1/2" iron by single proportionate methods between found corner at corner common to Sections 3, 4, 9 and 10 (G3) and calculated location of corner at corner common to Sections 9, 10, 15 and 16 (G5)
Corner falls at center of old fire lane North-South

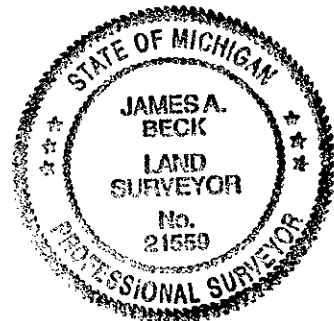

C. Description of monument for corner and accessories established to perpetuate locating the position of the corner:

G4 1/2" iron with P.S. 21559 cap

Witnesses:
N59°E 52.76', 8" Maple
N 26°W 22.07', 6" Maple
S 68°W 24.33', 4" Basswood
S 76°E 23.90', 6" Black Ash

Ratified by Peer Group
in accordance with P.A. 345
Chairman *Delmer Fortis*
Date 11/21/95

P.S. 21559 tags set in trees

Signed by James A. Beck
Surveyor's Michigan License No. 21559

Date 11-28-1995