

LAND CORNER RECORDATION CERTIFICATE
Filing Requirement of Act 74, Mich. P.A. 1970

For corners in

PRESQUE ISLE Located In: Corner Code M 8
(County)

1. Public Land Survey T 36N R 2E M 8
T R
T R
T R

2. Property Controlling S T R
in Section S T R

3. Miscellaneous S T R
Property in Sec. S T R

4. Lot No. , Recorded Plat
5. Private Claims

I, James A. Beck, in a field survey on March 23, 19 94, do hereby certify that under requirements of P.A. 74, Michigan P.A. of 1970, the corner points mentioned in lines 1 and 2 above were in conformance with regulations and rules therefore as required in the current manual of survey instructions of the United States Department of the Interior, Bureau of Land Management or by a decree of a Court of Law and/or that the corner points mentioned in lines 3, 4 and 5 above were in conformance with the rules of the Michigan Board of Land Surveyors or by a Decree of a Court of Law; established, re-established, monumented, re-monumented, recovered, found as expressed below:

NOTE: Not more than 4 corners, all in the same town and range, may be recorded on this certificate.

A. Description of original monument and accessories and/or subsequent restoration:

M 8 1856: Set post and referenced:
Government Resurvey W Birch 11" N39°W 46 Links
Cedar 10" S9 1/2°E 35 1/2 Links

Delmer E. Porter P.S. 15410 set 4" concrete monument by single proportion. Referenced: Survey recorded
N86°W 31.19' 10" Birch Nov. 24, 1975,
S61°E 15.47' 19" Oak L. 210, P. 557,
S14°W 45.81' 17" Oak Presque Isle
County Records.

B. Description of corner evidence found and/or method applied in restoring or reestablishing corner:

M 8 Found concrete monument with 1/2" iron
1994 rod and cap P.S. 15410 (Delmer Porter)

Found two previously recorded witnesses.

S61°E 15.47' 22" Oak*
S14°W 45.81' 20" Oak*

C. Description of monument for corner and accessories established to perpetuate locating the position of the corner:


M-8 Concrete monument with 1/2" iron
1994 rod and cap P.S. 15410 (Delmer Porter) in line of wooden posts opposite the Easterly side of 2-story cottage 180' ± North of lake.

Witnesses:
S61°E 15.47' 22" Oak*
S14°W 45.81' 20" Oak*

new: S40°W 20.15' SE Corner House Wood Siding
new: N62°W 14.71' NE Corner House Wood Siding
new: N38°E 43.41' 6" Oak*

* = Set tag P.S. 21559

Ratified by Peer Group
in accordance with P.A. 345
Chairman Delmer E. Porter
Date August 29, 1994

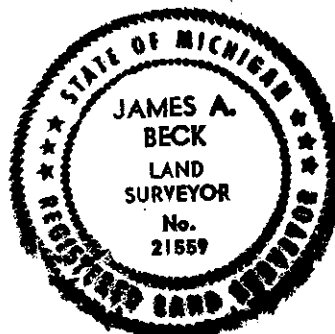

Signed by James A. Beck Date August 25, 1994
Surveyor's Michigan License No. 21559