

2216 SURVEY & MONUMENTATION 1995 PRESQUE ISLE COUNTY, STATE OF MICHIGAN REMONUMENTATION

LAND CORNER RECORDATION CERTIFICATE

Filing Requirement of Act 74, Mich. P.A. 1970

For corners in

JAN 17 1996

PRESQUE ISLE COUNTY
RECORDED

95 OCT 20 PM 4:29

PRESQUE ISLE
(County)

COMMISSION

Recorded In:

Corner Code #

1. Public Land Survey T 36N R 2E M.C. North
T R side of Clear
T R Lake on Sec.
T R line betw.
sec. 1 & 2
M.P. 4
2. Property Controlling S T R
in Section S T R
3. Miscellaneous S T R
Property in Sec. S T R

Janet M. Stand
REGISTER OF DEEDS

LIBER 316 PAGE 299

Register of Deeds Stamp & File Number

4. Lot No. , Recorded Plat

5. Private Claims

I, Ronald Bischer, in a field survey on June 19, 19 95, do hereby certify that under requirements of P.A. 74, Michigan P.A. of 1970, the corner points mentioned in lines 1 and 2 above were in conformance with regulations and rules therefore as required in the current manual of survey instructions of the United States Department of the Interior, Bureau of Land Management or by a decree of a Court of Law and/or that the corner points mentioned in lines 3, 4 and 5 above were in conformance with the rules of the Michigan Board of Land Surveyors or by a Decree of a Court of Law; established, re-established, monumented, re-monumented, recovered, found as expressed below:

NOTE: Not more than 4 corners, all in the same town and range, may be recorded on this certificate.

A. Description of original monument and accessories and/or subsequent restoration:

GL0 Resurvey Notes

Geo. H. Cannon

Set wood post

Cedar 9" N87½°E 60 lks

04-29-77 Delmar E. Porter

½" Rod & old Cedar stakes

N17°E 6.25' 8" Cedar

S63°E 27.70' 12" W. Pine

East 33' Cedar (NBT)

05-05-77 Ronald R. Bischer

Found 3"x3" Cedar stake also very stake point and two witnesses

½" rod and Cap

N17°E 6.25' 8" Cedar

S63°E 27.70' 12" W. Pine

B. Description of corner evidence found and/or method applied in restoring or reestablishing corner:

Found ½" Rod and Cap #15410, 3"x3" cedar post and very old stake point.

N13°E 5.70' 10" Cedar

very old witness - could have been witnessed 50-100 years ago.

S56°E 28.40' 16" W. Pine

KZM

	A	B	C	D	E	F	G	H	I	J	K	L	M
2	6	5	4	3	2	1							
3													
4	7	8	9	10	11	12							
5													
6	18	17	16	15	14	13							
7													
8	19	20	21	22	23	24							
9													
10	30	29	28	27	26	25							
11													
12	31	32	33	34	35	36							
13													

C. Description of monument for corner and accessories established to perpetuate locating the position of the corner:

½" Rod and Cap #15410

S03°E 16.28' 4" Cedar

N72°E 37.10' 6" Cedar

N13°E 5.70' 10" Cedar


S56°E 28.40' 16" White Pine

Nails and witness tag #22428 used.

Ratified by Peer Group
in accordance with P.A. 345

Chairman Delmar E. Porter

Date 9/20/95

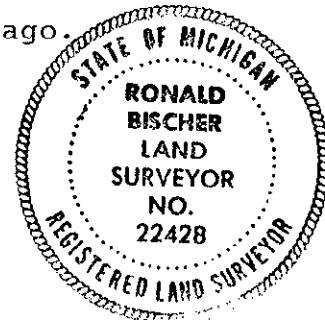

Signed by Ronald R. Bischer

Date Oct. 3, 1995

Surveyor's Michigan License No. 22428