

## LAND CORNER RECORDATION CERTIFICATE

LIBER 316 PAGE 298

For corners in JAN 17 1996

Filing Requirement of Act 74, Mich. P.A. 1970

PRESQUE ISLE COUNTY  
RECORDS

95 OCT 20 PM 4:29

Janet M. Slamb  
REGISTER OF DEEDS

Register of Deeds Stamp &amp; File Number

PRESQUE ISLE  
(County) COMMISSION

Corner Code ##

1. Public Land Survey T 36N R 2E M.C. West  
T R side Clear  
T R Lake on sec.  
T R line betw.  
2. Property Controlling S T sec. 2 & 11  
in Section S T M.P. 5  
3. Miscellaneous S T  
Property in Sec. S T

4. Lot No. , Recorded Plat  
5. Private Claims

I, Ronald Bischer, in a field survey on July 20, 19 95, do hereby certify that under requirements of P.A. 74, Michigan P.A. of 1970, the corner points mentioned in lines 1 and 2 above were in conformance with regulations and rules therefore as required in the current manual of survey instructions of the United States Department of the Interior, Bureau of Land Management or by a decree of a Court of Law and/or that the corner points mentioned in lines 3, 4 and 5 above were in conformance with the rules of the Michigan Board of Land Surveyors or by a Decree of a Court of Law; established, re-established, monumented, re-monumented, recovered, found as expressed below:

**NOTE: Not more than 4 corners, all in the same town and range, may be recorded on this certificate.**

## A. Description of original monument and accessories and/or subsequent restoration:

GLO Resurvey Notes - 1856  
Geo. H. Cannon  
Set wood post  
Tamarack 12" N50°W 67 lks  
Tamarack 7" S60°W 37 lks


S14°W 25.03' 12" Maple  
S88°W 6.03' 5" Maple  
N12°E 27.27' 5" Maple

02-02-88 Delmar E. Porter  
Corner restored at intersection  
of Lake on section line.

## B. Description of corner evidence found and/or method applied in restoring or reestablishing corner:

Found 1/2" Rod and Cap #15410  
S71°W 6.03' 7" Maple  
S02°W 25.03' 16" Maple  
N20°E 27.27' 8" Maple

S60°W 37 lks 7" Tamarack - OBT stump - foot blaze visible

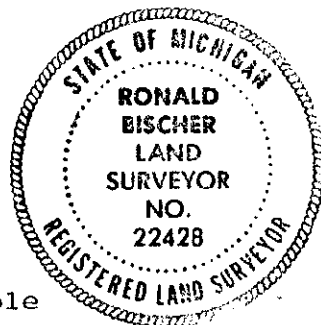

## C. Description of monument for corner and accessories established to perpetuate locating the position of the corner:

1/2" Rod and Cap #15410  
S71°W 6.03' 7" Maple  
S02°W 25.03' 16" Maple  
N11°W 59.65' 5" Spruce  
N20°E 27.27' 8" Maple

Ratified by Peer Group  
in accordance with P.A. 345

Chairman Delmar E. Porter  
Date 9/20/95

Nails with witness tag #22428 used.

Signed by Ronald R. Bischer

Date Oct. 3, 1995

Surveyor's Michigan License No. 22428