

2219 MONUMENTATION

LAND CORNER RECORDATION CERTIFICATE

Filing Requirement of Act 74, Mich. P.A. 1970

For corners in

JAN 17 1996

PRESQUE ISLE
(County)

COMMISSION

Corner Code -##

LIBER 316 PAGE 302

PRESQUE ISLE COUNTY
RECORDED

95 OCT 20 PM 4:30

Janet M. Lamb
REGISTER OF DEEDS

Register of Deeds Stamp & File Number

1. Public Land Survey T 36N R 2E M.C. E. side
T R Clear Lake
T R on Section
T R line betw.
2. Property Controlling S T R Sec 1 & 12
in Section S T R N.P. - 6
3. Miscellaneous S T R
Property in Sec. S T R
4. Lot No. _____, Recorded Plat _____
5. Private Claims _____

I, Ronald Bischer, in a field survey on July 10, 19 95, do hereby certify that under requirements of P.A. 74, Michigan P.A. of 1970, the corner points mentioned in lines 1 and 2 above were in conformance with regulations and rules therefore as required in the current manual of survey instructions of the United States Department of the Interior, Bureau of Land Management or by a decree of a Court of Law and/or that the corner points mentioned in lines 3, 4 and 5 above were in conformance with the rules of the Michigan Board of Land Surveyors or by a Decree of a Court of Law; established, re-established, monumented, re-monumented, recovered, found as expressed below:

NOTE: Not more than 4 corners, all in the same town and range, may be recorded on this certificate.

A. Description of original monument and accessories and/or subsequent restoration:

1856 Resurvey - GLO notes
Geo. H. Cannon
Set wood post
Y. Pine 14" S63 E 70 lks
Y. Pine 12" N22 E 10 lks

05-05-77 - Ronald R. Bischer
Same as Porter 04-29-77

06-07-82 - Delmar E. Porter
same as Porter 04-29-77

11-04-94 - Norman J. Quaine
same as Porter 04-29-77


04-29-77 Delmar E. Porter
Well point
N09°W 17.75' 14" N. Pine
S19°E 16.55' 10" Oak

B. Description of corner evidence found and/or method applied in restoring or reestablishing corner:

Found Well point

N09°W 17.75' 12" N. Pine
S19°E 16.55' 12" Oak

Set ½" Rod and Cap #22428 inside Well point.

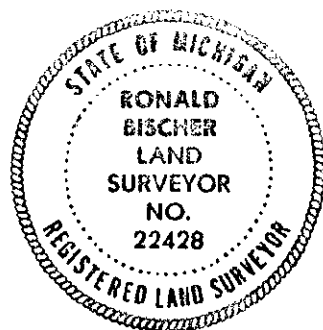

C. Description of monument for corner and accessories established to perpetuate locating the position of the corner:

½" Rod and Cap #22428 inside well point
N09°W 17.75' 12" Norway Pine
S19°E 16.55' 12" Oak
N82°E 37.44' 12" Norway Pine
S07°W 34.10' 12" Norway Pine

Nails with witness tag #22428 used.

Ratified by Peer Group
in accordance with P.A. 345

Chairman Delmar E. Porter

Date 9/20/95

Signed by Ronald R. Bischer

Date Oct. 3, 1995

Surveyor's Michigan License No. 22428