

SURVEY & MONUMENTATION

1995 PRESQUE ISLE COUNTY, STATE OF MICHIGAN REMONUMENTATION

0017

JAN 17 1996

LAND CORNER RECORDATION CERTIFICATE

LIBER 316 PAGE 300

For corners in

COMMISSION

Filing Requirement of Act 74, Mich. P.A. 1970

PRESQUE ISLE COUNTY
RECORDED

95 OCT 20 PM 4: 29

Janet M. Lamb
REGISTER OF DEEDS

Register of Deeds Stamp & File Number

PRESQUE ISLE
(County)

Located In:

Corner Code: #

1. Public Land Survey T 36 NR 2E
T R
T R
T R
2. Property Controlling S T R
in Section S T R
3. Miscellaneous S T R
Property in Sec. S T R

M.C. on S.
side Clear
Lake on sec.
line betw.
sec. 11 & 12
M.P. 7

4. Lot No. , Recorded Plat
5. Private Claims

I, Ronald Bischer, in a field survey on June 19, 19 95, do hereby certify that under requirements of P.A. 74, Michigan P.A. of 1970, the corner points mentioned in lines 1 and 2 above were in conformance with regulations and rules therefore as required in the current manual of survey instructions of the United States Department of the Interior, Bureau of Land Management or by a decree of a Court of Law and/or that the corner points mentioned in lines 3, 4 and 5 above were in conformance with the rules of the Michigan Board of Land Surveyors or by a Decree of a Court of Law; established, re-established, monumented, re-monumented, recovered, found as expressed below:


NOTE: Not more than 4 corners, all in the same town and range, may be recorded on this certificate.

A. Description of original monument and accessories and/or subsequent restoration:

GLO Resurvey Notes
Geo. H. Cannon
Set wood post
Cedar 10" S02°W 35 lks
Cedar 9" S64°E 21 lks
04-21-87 Delmar E. Porter
Set 1/2" Rod
No witnesses recorded.

B. Description of corner evidence found and/or method applied in restoring or reestablishing corner:

Found 1/2" Rod and cap #15410.
Found OBT stump, set 1/2" Rod and cap #22428 from stump.
Rod and Cap #15410 is 3.21 feet South.

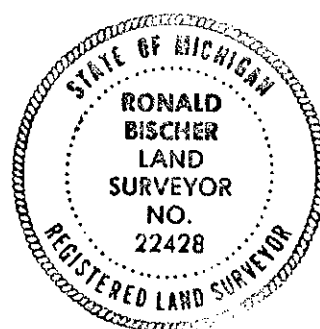

C. Description of monument for corner and accessories established to perpetuate locating the position of the corner:

1/2" Rod and Cap #22428
S13°W 10.88' 10" Cedar
West 1.05' 7" Cedar
S31°E 7.47' 9" Cedar
S79°E 7.37' 5" Cedar
South 3.21' 1/2" Rod and Cap #15410
S02°W 35 lks OBT Cedar stump

Ratified by Peer Group
in accordance with P.A. 345
Chairman *Delmar E. Porter*
Date 9/20/95

Nails with witness tag #22428 used.

Signed by Ronald R. Bischer

Date Oct. 3, 1995

Surveyor's Michigan License No. 22428