

MAR 18 1998

SAGINAW COUNTY RE-MON 1997
LAND CORNER RECORDATION CERTIFICATE RECORDED & FILED
Filing Requirement of Act 74, Mich. P.A. 1970

SECTION

For corners in Taymouth Township

<u>Saginaw</u> (County)	Located In:	Corner Code #
1. Public Land Survey	T <u>10N</u> R <u>5E</u>	<u>A-13</u>
	T _____ R _____	_____
	T _____ R _____	_____
	T _____ R _____	_____
2. Property Controlling in Section	S _____ T _____ R _____	_____
	S _____ T _____ R _____	_____
3. Miscellaneous Property in Sec.	S _____ T _____ R _____	_____
	S _____ T _____ R _____	_____

SEP 25 3 24 PM '97

MILDRED M. DODAK
REGISTER OF DEEDS
SAGINAW COUNTY MICH.

LIBER 2027 PAGE 94

Liber 7 Page 134
Register of Deeds Stamp & File Number

4. Lot No. _____, Recorded Plat _____
5. Private Claims _____

I, Ronald C. Prevost, in a field survey on 4-29, 19 97 do hereby state that under requirements of P.A. 74, Michigan P.A. of 1970, the corner points mentioned in lines 1 and 2 above were in conformance with regulations and rules therefore as required in the current manual of survey instructions of the United States Department of the Interior, Bureau of Land Management or by a decree of a Court of Law and for that the corner points mentioned in lines 3, 4 and 5 above were in conformance with the rules of the Michigan Board of Land Surveyors or by a Decree of a Court of Law; established, re-established, monumented, recovered, found as expressed below:

NOTE: Not more than 2 corners, all in the same town and range, may be recorded on this certificate.

A	B	C	D	E	F	G	H	I	J	K	L	M
1												
2	6	5	4	3	2	1						
3												
4	7	8	9	10	11	12						
5												
6	18	17	16	15	14	13						
7												
8	19	20	21	22	23	24						
9												
10	30	29	28	27	26	25						
11												
12	31	32	33	34	35	36						
13												

A. Description of original monument and accessories and/or subsequent restoration:

A-13 Post set by J. Wampler about 1822.
Beech 16 in. S.35°W 5 L
Beech 18 in. N.38°E. 43 L
L.C.R.C. L2-Pg 21, Leach, 1972 3/4" rod/mon box, f'nd
Act 132 L.1452-P932, Leach
Act 132 L.1667-P219, Leach
Act 132 L.1668-P2289, Leach

APPROVED BY PEER GROUP
P.A. 345 OF 1990
SAGINAW COUNTY


6-26-97 [Signature]

B. Description of corner evidence found and/or method applied in restoring or reestablishing corner:

A-13 Found 3/4" rod/mon box, 4-29-97.
L.2-Pg.21 N.45°W. 72.60 top conc. r/w marker (M 72.70)
L.1667-Pg 219 S.45°E. 96.70 N & T S'y face p. pole (M 96.70)
Peer Group Approved 6-26-97.

C. Description of monument for corner and accessories established to perpetuate locating the position of the corner:

A-13 Replaced 3/4" rod with 5/8" re-rod, Sag. Co. re-mon cap in existing mon box, 7-1-97.
S.60°E. 96.70 M.S.H.D. tag SW'ly face p. pole.
N.70°E. 95.15 M.S.H.D. tag NW'ly face p. pole
N.45°W. 72.70 project marker
S.45°W. 119.35 nail & cap NW'ly face 20" Pine.

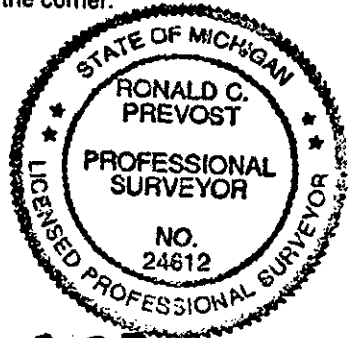

Signed by Ronald C. Prevost
Ronald C. Prevost

Date 9-25-97

Surveyor's Michigan License No. 24612