

SAGINAW COUNTY REMONUMENTATION

LIBER 1887 PAGE 1015

DEC 15 1993

LAND CORNER RECORDATION CERTIFICATE
Filing Requirement of Act 74, Mich. P.A. 1970

COMMISSION
RECORDED & FILED

For corners in
Saginaw
(County)

Located In: Corner Code #

1. Public Land Survey T 12 N. R 4 E. A-2
T R
T R
T R
2. Property Controlling S T R
in Section S T R
3. Miscellaneous S T R
Property in Sec. S T R

Dec 9 4 26 PM '93

MILDRED M. BODAK
REGISTER OF DEEDS
SAGINAW COUNTY MICH.

Liber 6 Page 160
Register of Deeds Stamp & File Number

4. Lot No. , Recorded Plat
5. Private Claims

I, Ronald C. Prevost, in a field survey on Oct./Dec., 19 93, do hereby certify that under requirements of P.A. 74, Michigan P.A. of 1970, the corner points mentioned in lines 1 and 2 above were in conformance with regulations and rules therefore as required in the current manual of survey instructions of the United States Department of the Interior, Bureau of Land Management or by a decree of a Court of Law and/or that the corner points mentioned in lines 3, 4 and 5 above were in conformance with the rules of the Michigan Board of Land Surveyors or by a Decree of a Court of Law; established, re-established, monumented, re-monumented, recovered, found as expressed below:

NOTE: Not more than 4 corners, all in the same town and range, may be recorded on this certificate.

	A	B	C	D	E	F	G	H	I	J	K	L	M
2	6	5	4	3	2	1							
3													
4	7	8	9	10	11	12							
5													
6	18	17	16	15	14	13							
7													
8	19	20	21	22	23	24							
9													
10	30	29	28	27	26	25							
11													
12	31	32	33	34	35	36							
13													

A. Description of original monument and accessories and/or subsequent restoration:

- A-2 Corner Not Set in Original Survey
Corner Set & Recorded as 3/4" Pipe by P.S. #23175, Liber 5, Pg. 14. on line between M-2 & M-3, T.12 N.-R.3 E., and in line with tree line to East.
S.25°E. 89.65 Cross on Ctr. S. Hdwl. Culv.
S.30°E. 99.85 Face P. Pole
North 17.00 3/4" Pipe E 1/4 Cor. Sec. 1, T.12 N.-R.3 E.
N.85°W. 39.20 Face 4" Oak
N.80°W. 24.20 Ctr. Catchbasin


B. Description of corner evidence found and/or method applied in restoring or reestablishing corner:

- A-2 Found 3/4" Pipe as per Liber 5, Pg. 14, and is accepted as: This position not established by original government surveyors. The monument is accepted as the best available evidence of the position of the corner.

Ratified by Saginaw County Peer Review Group 9-23-93

C. Description of monument for corner and accessories established to perpetuate locating the position of the corner:

- A-2 Set 5/8" x 18" Re-bar with Saginaw Co. Re-mon Bronze Cap Stamped #24612 & Mon. Box in place of 3/4" pipe.
E.1/4 Cor. Sec. 1, T.12 N.-R.3 E., North 17.00
Nail & Cap E. Face Power Pole S.30°E. 102.55
Cross on Ctr. S. Hdwl. Culvert S.25°E. 89.65
Hydrant S.20°W. 65.50
Nail & Cap E. Face P. & T. Pole S.30°W. 49.58

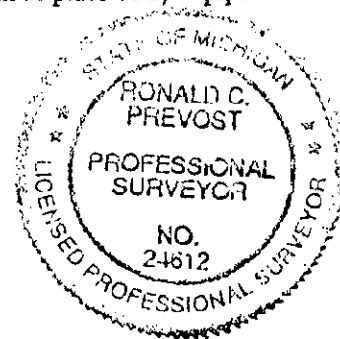

Signed by Ronald C. Prevost

Date 12-9-93

24612

Surveyor's Michigan License No. _____