

SAGINAW COUNTY REMONUMENTATION

LIBER 1887 PAGE 1022

1993

LAND CORNER RECORDATION CERTIFICATE

Filing Requirement of Act 74, Mich. P.A. 1970

COMMISSION

RECORDED & FILED

For corners in  
Saginaw  
(County)

Located In:

Corner Code =#

1. Public Land Survey T 12 N. R 4 E. C-6  
T R  
T R  
T R
2. Property Controlling S T R  
in Section S T R
3. Miscellaneous S T R  
Property in Sec. S T R

DEC 9 4 27 PM '93

HILKKE J. JUDAR  
REGISTER OF DEEDS  
SAGINAW COUNTY MICH.

*Liber 6 Page 167*  
Register of Deeds Stamp & File Number

4. Lot No. , Recorded Plat
5. Private Claims

I, Ronald C. Prevost, in a field survey on Oct./Dec., 19 93, do hereby certify that under requirements of P.A. 74, Michigan P.A. of 1970, the corner points mentioned in lines 1 and 2 above were in conformance with regulations and rules therefore as required in the current manual of survey instructions of the United States Department of the Interior, Bureau of Land Management or by a decree of a Court of Law and/or that the corner points mentioned in lines 3, 4 and 5 above were in conformance with the rules of the Michigan Board of Land Surveyors or by a Decree of a Court of Law; established, re-established, monumented, re-monumented, recovered, found as expressed below:

**NOTE: Not more than 4 corners, all in the same town and range, may be recorded on this certificate.**

A. Description of original monument and accessories and/or subsequent restoration:


- C-6 Post Set by J. Wampler in 1822.  
C-6 3/4" Pipe Recorded Liber 4, Pg. 65 (Re-set after pv't. construction)  
N.45°E. 35.15 Ctr. Catchbasin  
N. 0°E. 13.03 N. Edge Bit. Pvt.  
S.45°W. 33.18 Ctr. Manhole

B. Description of corner evidence found and/or method applied in restoring or reestablishing corner:

- C-6 Found 3/4" Pipe @ Bit. Surface, and is accepted as the best available evidence of the position of the original corner.  
Ratified by Saginaw County Peer Review Group 9-30-93

C. Description of monument for corner and accessories established to perpetuate locating the position of the corner:

- C-6 Set 5/8" x 18" Re-bar with Saginaw Co. Re-Mon Bronze Cap Stamped #24612 and Mon. Box in place of 3/4" Pipe.  
Nail & Cap in Ctr. 4" Concrete Filled Steel Post N.45°E. 71.15  
NE Cor. Brick Aptm't Bldg. S.30°E. 86.70  
Ctr. Hyd. S.50°W. 64.75  
Nail & Cap in Ctr. 4" Concrete Filled Steel Post N.45°W. 68.63

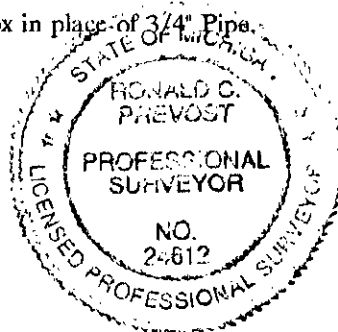

Signed by Ronald C. Prevost  
Surveyor's Michigan License No. 24612

Date 12-9-93