

LAND CORNER RECORDATION CERTIFICATE

1993

FILING REQUIREMENT OF ACT 74, MICH. P.A. 1970

COMMISSION

FOR CORNERS OF--	LOCATED IN--	CORNER CODE NUMBER
1. PUBLIC LAND SURVEY	T. 12 N. S. R. 4 E. W.	G-11
2. PROPERTY CONTROLLING IN SECTION	T. N. S. R. E. W.	
3. MISCELLANEOUS PROPERTY IN SECTION	T. N. S. R. E. W.	
4. LOT NO.	RECORDED PLAT	
5. PRIVATE CLAIMS		

RECORD FILED
Lib 6 Page 188
 Dec 22 2 14 PM '93
 HILL LODAK
 REGISTER OF DEEDS
 SAGINAW COUNTY MICH.
 REGISTER OF DEEDS STAMP AND
 FILING NUMBER

I, Duane F. Ledy, do hereby certify that under requirements of P.A. 74, Michigan P.A. of 1970, the corner points mentioned in lines 1 and 2 above were, in a field survey on September, 1993, established, re-established, monumented, re-monumented, recovered or restored as expressed below and in conformance with regulations and rules therefore as required in the current manual of survey instructions of the United States Department of the Interior, Bureau of Land Management or by a decree of a court of law. Furthermore, that the corner points mentioned in lines 3, 4 and 5 above were, in a field survey on September, 1993, found, recovered, restored, established or re-established as expressed below and in conformance with the rules of the Michigan State Board of Registration for Land Surveyors or, by a Decree of a Court of law:

A. Description of original monument and accessories and/or subsequent restoration:

Wood post set in 1822 by Wampler at 80.00 chains. No records available of date or method of placement of existing monument at G-11.

B. Description of corner evidence found and/or method applied in restoring or re-establishing corner:


Found 2" steel City of Saginaw monument. Existing corner referenced in 1917 City of Saginaw Surveys, no witnesses. Measurements agree with City of Saginaw resurveys. Corner witness to Golfside Subdivision and Saginaw Improvement Company Addition G. Corner ratified by Saginaw County Remonumentation Peer Group Review on October 7, 1993.

C. Description of monument for corner and accessories established to perpetuate locating the position of the corner:

Set 5/8" rod and Sag. Co. Remon. 3" brass cap.

South	45.15	City monument in centerline of Burrows Street
North	13.20	Nail and brass tag marked "P.S. 21575" in centerline of railroad tracks
N 60 W	40.07	Nail and brass tag marked "P.S. 21575" in centerline of railroad tracks
N 40 E	41.23	Nail and brass tag marked "P.S. 21575" in centerline of railroad tracks

SIGNED BY Duane F. Ledy DATE Dec. 22, 1993
 SURVEYOR'S MICHIGAN REGISTRATION NO. 21575
 FOR STATE AND UNITED STATES AGENCIES:
 SIGNED BY _____ DATE _____
CHIEF OF SURVEY PARTY
 APPROVED AND SIGNED BY _____ DATE _____
MICHIGAN REGISTERED LAND SURVEYOR

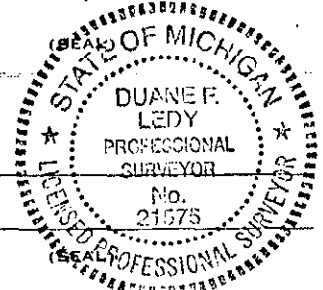

SURVEYOR'S MICHIGAN REGISTRATION NO. _____