

APPROVED BY PEER GROUP
P.A. 345 OF 1990
SAGINAW COUNTY
SAGINAW COUNTY REMONUMENTATION 1999
LAND CORNER RECORDATION CERTIFICATE
Filing Requirement of Act 74, Mich. P.A. 1970

For corners in

Saginaw
(County)

Located in:
Kochville Twp.

Corner Code #

1. Public Land Survey T 13N R 4E B-11
T R
T R
T R

2. Property Controlling S T R
in Section S T R

3. Miscellaneous S T R
Property in Sec. S T R

SEP 28 3 16 PM '99

MICHIGAN
REGISTER OF DEEDS
SAGINAW COUNTY MICH.

LIBER 2144 PAGE 744

Liber 8 Page 16

Register of Deeds Stamp & File Number

4. Lot No. , Recorded Plat
5. Private Claims

I, Roger P. Mahoney, in a field survey on 4-6, 1999 do hereby state that under requirements of P.A. 74, Michigan P.A. of 1970, the corner points mentioned in lines 1 and 2 above were in conformance with regulations and rules therefore as required in the current manual of survey instructions of the United States Department of the Interior, Bureau of Land Management or by a decree of a Court of Law and /or that the corner points mentioned in lines 3, 4 and 5 above were in conformance with the rules of the Michigan Board of Land Surveyors or by a Decree of a Court of Law; established, re-established, monumented, recovered, found as expressed below:

NOTE: Not more than 2 corners, all in the same town and range, may be recorded on this certificate.

	A	B	C	D	E	F	G	H	I	J	K	L	M
1													
2		6		5		4		3		2		1	
3													
4		7		8		9		10		11		12	
5													
6		16		17		18		19		20		21	
7													
8		19		20		21		22		23		24	
9													
10		30		29		28		27		26		25	
11													
12		31		32		33		34		35		36	
13													

A. Description of original monument and accessories and/or subsequent restoration:

B-11 Post set by D.S. Joseph Wampler, 1822.
Elm 9" N. 7 Lks.
Beech 12" S.30°W. 26 Lks.


B. Description of corner evidence found and/or method applied in restoring or reestablishing corner:

B-11 Found 3/4" pipe.
Spicer notes 1966 fnd 3/4" pipe.
LCRC L1 P198 McKelvoy 1972 1" pipe.
SCRC notes 1974 3/4" pipe.

Monument accepted as the best available evidence of the position of the original corner.

C. Description of monument for corner and accessories established to perpetuate locating the position of the corner:

B-11 Replaced 3/4" pipe with 5/8" bar, Saginaw County re-mon cap stamped #24612 & mon box.
South 33.08 40 N. nail W. side 42" Oak. (rec 31.57 face Spicer 1966)(rec 33.08 L1 P198)(rec SCRC 32.92)
S.30°E. 38.36 40 N nail E. side 30" Maple (rec 36.76 face Spicer 1966)(rec 37.10 L1 P198)
West 4.5' farm ditch to North on bituminous road East & West.
N.55°W. 22.85' set 3/4" pipe on shoulder of road.
N.65°E. 19.76' set 3/4" pipe on shoulder of road.

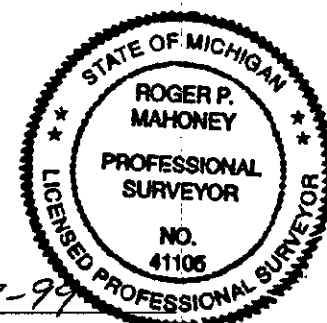

Signed by

Roger P. Mahoney

Date

9-27-99

Surveyor's Michigan License No. 41105