

APPROVED BY PEER GROUP

P.A. 345 OF 1990

SAGINAW COUNTY

SAGINAW COUNTY REMONUMENTATION 1999

LAND CORNER RECORDATION CERTIFICATE

Filing Requirement of Act 74, Mich. P.A. 1970

RECORDED & FILED

SEP 28 3 16 PM '99

For corners in

<u>Saginaw</u> (County)	Located In: <u>Kochville Twp.</u>	Corner Code #
1. Public Land Survey	T <u>13N</u> R <u>4E</u> <u>C-10</u>	
	T _____ R _____	
	T _____ R _____	
	T _____ R _____	
2. Property Controlling	S _____ T _____ R _____	
in Section	S _____ T _____ R _____	
3. Miscellaneous	S _____ T _____ R _____	
Property in Sec.	S _____ T _____ R _____	
4. Lot No. _____, Recorded Plat _____		
5. Private Claims _____		

MICHIGAN  
REGISTER OF DEEDS  
SAGINAW COUNTY MICH.

LIBER 2144 PAGE 741

*Liber 8 Page 13*

Register of Deeds Stamp & File Number

I, Roger P. Mahoney, in a field survey on 4-6, 1999 do hereby state that under requirements of P.A. 74, Michigan P.A. of 1970, the corner points mentioned in lines 1 and 2 above were in conformance with regulations and rules therefore as required in the current manual of survey instructions of the United States Department of the Interior, Bureau of Land Management or by a decree of a Court of Law and /or that the corner points mentioned in lines 3, 4 and 5 above were in conformance with the rules of the Michigan Board of Land Surveyors or by a Decree of a Court of Law; established, re-established, monumented, recovered, found as expressed below:

NOTE: Not more than 2 corners, all in the same town and range, may be recorded on this certificate.

	A	B	C	D	E	F	G	H	I	J	K	L	M
1													
2		6		5		4		3		2		1	
3													
4		7		8		9		10		11		12	
5													
6		18		17		16		15		14		13	
7													
8		19		20		21		22		23		24	
9													
10		30		29		28		27		26		25	
11													
12		31		32		33		34		35		36	
13													

A. Description of original monument and accessories and/or subsequent restoration:

C-10 Post set by D.S. Joseph Wampler, 1822.  
Elm 24" S.12°W. 11 Lks.  
Beech 9" N.38°E. 19 Lks.

B. Description of corner evidence found and/or method applied in restoring or reestablishing corner:


C-10 Found 3/4" pipe.  
Spicer notes 1967 set nail.  
LCRC L2 P241 Martin, 1974 3/4" pipe.  
Spicer notes 1975 3/4" pipe.  
Spicer notes 1978 3/4" pipe.

Monument accepted as the best available evidence of the position of the original corner.

C. Description of monument for corner and accessories established to perpetuate locating the position of the corner:

C-10 Replaced 3/4" pipe with 5/8" bar, Sag. Co. re-mon cap stamped #24612 & mon box.  
S.20°W. 53.58 SE cor. conc. hdwl (high point)(rec 53.58 L2 P241)(Spicer notes 1978 53.58).  
S.30°W. 57.07 NW cor. conc. hdwl (high point)(rec 57.07 L2 P241)(Spicer notes 1978 57.07).  
S.55°E. 32.54 top center hydrant.  
N.75°W. 31.61 set nail & tag N. face P. pole.

SURVEY &  
RECORDED  
MAR 09 2000  
SECTION

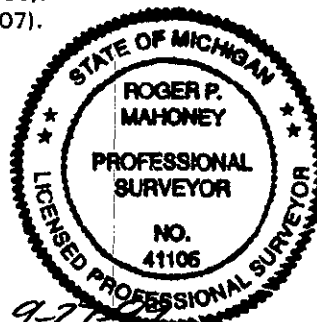

Signed by

Roger P. Mahoney  
Roger P. Mahoney

Date

9-21-99

Surveyor's Michigan License No. 41105