

JAN 22 2001

LIBER 3 PAGE 33

RECEIVED FOR RECORD

SECTION

2000 Remonumentation Program
LAND CORNER RECORDATION CERTIFICATE
Filing Requirement of Act 74, Mich. P.A. 1970.

00 NOV 27 AM 8:55

For corners in

LIBER NO. 3 PAGE NO. 33
MICHELE VANNORMAN
REGISTER OF DEEDS
SANILAC CO., MICHIGAN

<u>Sanilac</u> (County)	Located In:	Corner Code #
1. Public Land Survey	T11N R15E	K - 1
	T R	
	T R	
	T R	
2. Property Controlling in Section	S T R	
	S T R	
3. Miscellaneous Property in Sec.	S T R	
	S T R	

Register of Deeds Stamp & File Number

i. Lot No. _____, Recorded Plat _____
j. Private Claims _____

John A Milletics, in a field survey on May 1, ~~198~~ 2000 do hereby state that under requirements of P.A. 74, Michigan P.A. of 1970, the corner points mentioned in lines 1 and 2 above were in conformance with regulations and rules therefore as required in the current manual of survey instructions of the United States Department of the Interior, Bureau of Land Management or by a decree of a Court of Law and/or that the corner points mentioned in lines 3, 4 and 5 above were in conformance with the rules of the Michigan Board of Land Surveyors or by a Decree of a Court of Law, established, re-established, monumented, discovered, found as expressed below:

	A	B	C	D	E	F	G	H	I	J	K	L	M
2	6		5		4		3		2		1		
4	7		8		9		10		11		12		
6	18		17		16		15		14		13		
8	19		20		21		22		23		24		
10	30		29		28		27		26		25		
12	31		32		33		34		35		36		


NOTE: Not more than 2 corners, all in the same town and range, may be recorded on this certificate.

Description of original monument and accessories and/or subsequent restoration:

- GLO Notes
- Hemlock 20" S28°W 41 Links
- Beech 8" S52°E 42 Links
- Act 132 - I.E. Chope Oct 1972
- L.C.R.C. Forms - None
- Unrecorded Surveys - Milletics Nov 1990 - Milletics March 1993

Description of corner evidence found and/or method applied in restoring or reestablishing corner:

- K - 1
- NE Corner Section 2 T11N-R15E
- Found no corner on site - removed by State Highway during construction
- Set from previous surveys
- West 2667.60 feet to the N 1/4 Cor Section 2
- East 2648.47 feet to the N 1/4 Cor Section 1
- Accepted as best evidence

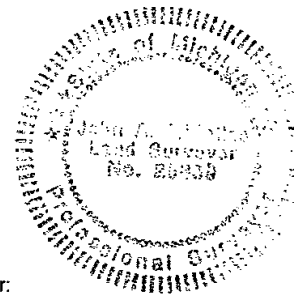

Description of monument for corner and accessories established to perpetuate locating the position of the corner:

- K - 1
- NE Corner Section 2 T11N-R15E
- 1/2" Iron with cap in pavement
- S30°E 56.35 feet to a nail in a Telephone Pole
- West 12.54 feet to the SE Corner Section 35
- N45°W 96.85 feet to a nail in a Power Pole
- N30°W 65.80 feet to a stop sign
- S35°E 33.25 feet to a stop sign
- North 13.00 feet to the centerline M- 46
- West 2667.60 feet to the N 1/4 Corner Section 2
- East 2648.47 feet to the N 1/4 Corner Section 1

APPROVED PEER BOARD
MEETING NOV 25 2000

gm

Witnessed by John A Milletics
Surveyor's Michigan License No. 25859

Date Nov 15, 2000