

JAN 22 2001

LIBER

3 JAN 28

RECEIVED FOR RECORD

SECTION

2000 Remonumentation Program
LAND CORNER RECORDATION CERTIFICATE
Filing Requirement of Act 74, Mich. P.A. 1970

00 NOV 27 AM 8:55

LIBER NO. 3 PAGE NO. 28

MICHELE VANNORMAN
REGISTER OF DEEDS
SANILAC CO., MICHIGAN

For corners in

Sanilac

(County)

Located In:

Corner Code #

1. Public Land Survey
- | | | | |
|--|------|------|-------|
| | T11N | R15E | M - 7 |
| | T | R | |
| | T | R | |
| | T | R | |
2. Property Controlling in Section
- | | | | |
|---|---|---|--|
| S | T | R | |
| S | T | R | |
3. Miscellaneous Property in Sec.
- | | | | |
|---|---|---|--|
| S | T | R | |
| S | T | R | |

Register of Deeds Stamp & File Number

1. Lot No. _____, Recorded Plat _____
2. Private Claims _____

John A Millettics, in a field survey on May 1, 2000 do hereby state that under requirements of P.A. 74, Michigan P.A. of 1970, the corner points mentioned in lines 1 and 2 above were in conformance with regulations and rules therefore as required in the current manual of survey instructions of the United States Department of the Interior, Bureau of Land Management or by a decree of a Court of Law and for that the corner points mentioned in lines 3, 4 and 5 above were in conformance with the rules of the Michigan Board of Land Surveyors or by a Decree of a Court of Law; established, re-established, monumented, discovered, found as expressed below:

NOTE: Not more than 2 corners, all in the same town and range, may be recorded on this certificate.

1	A	B	C	D	E	F	G	H	I	J	K	L	M
2	6		5		4		3		2		1		
3													
4	7		8		9		10		11		12		
5													
6	18		17		16		15		14		13		
7													
8	19		20		21		22		23		24		
9													
10	30		29		28		27		26		25		
11													
12	31		32		33		34		35		36		
13													

1. Description of original monument and accessories and/or subsequent restoration:

GLO Notes

Beech 10" N36°W 60Links

Beech 7" N46°W 17 3/4 Links

Act 132 - None

Unrecorded surveys - Sanilac Land Survey Aug 1977 - Sanilac Land Survey June 1978
Millettics Dec 1994

L.C.R.C. Forms - None

2. Description of corner evidence found and/or method applied in restoring or reestablishing corner:


M - 7

SE Corner Section 13 T11N-R15E

Found 1" Iron Bar 1' Deep in gravel road bed

West 2664.14 feet to the S 1/4 Corner Section 13

Accepted as best evidence

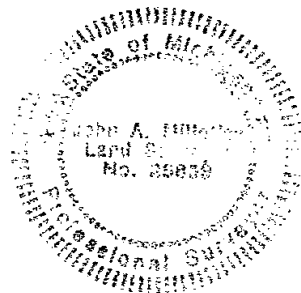

3. Description of monument for corner and accessories established to perpetuate locating the position of the corner:

M - 7

SE Corner Section 13 T11N-R15E

1" Iron bar in gravel road bed

N45°W 49.80 feet to a nail in a Telephone Pole

S50°W 37.70 feet to a stop sign

N45°W 37.10 feet to a stop sign

S45°E 38.50 feet to a stop sign

N45°E 34.00 feet to a stop sign

West 2664.14 feet to the S 1/4 Corner Section 13

APPROVED PEER BOARD
MEETING NOV 25 2000

97

signed by John A Millettics
Surveyor's Michigan License No. 25859

Date Nov 15, 2000