

JAN 22 2001

LIBER

3 PAGE 77

RECEIVED FOR RECORD

00 DEC -1 AM 9:33

SECTION

2000 REMONUMENTATION PROGRAM  
LAND CORNER RECORDATION CERTIFICATE  
Filing Requirement of Act 74, Mich. P.A. 1970

LIBER NO. 3 PAGE NO. 77  
MICHELE VANNORMAN  
REGISTER OF DEEDS  
SANILAC CO., MICHIGAN

For corners in

Sanilac (County)	Located In:	Corner Code #
1. Public Land Survey	T11NR 16E	C - 7
	T R	
	T R	
	T R	
2. Property Controlling in Section	S T R	
	S T R	
3. Miscellaneous Property in Sec.	S T R	
	S T R	

Register of Deeds Stamp & File Number

1. Lot No. \_\_\_\_\_, Recorded Plat \_\_\_\_\_  
i. Private Claims \_\_\_\_\_

2000  
John A Milletics, in a field survey on May 1998, do hereby state that under requirements of P.A. 74, Michigan P.A. of 1970, the corner points mentioned in lines 1 and 2 above were in conformance with regulations and rules therefore as required in the current manual of survey instructions of the United States Department of the Interior, Bureau of Land Management or by a decree of a Court of Law and/or that the corner points mentioned in lines 3, 4 and 5 above were in conformance with the rules of the Michigan Board of Land Surveyors or by a Decree of a Court of Law, established, re-established, monumented, covered, found as expressed below:

NOTE: Not more than 2 corners, all in the same town and range, may be recorded on this certificate.

	A	B	C	D	E	F	G	H	I	J	K	L	M
1													
2	6		5		4		3		2		1		
3													
4	7		8		9		10		11		12		
5													
6	18		17		16		15		14		13		
7													
8	19		20		21		22		23		24		
9													
10	30		29		28		27		26		25		
11													
12	31		32		33		34		35		36		
13													

Description of original monument and accessories and/or subsequent restoration:  
C - 7

GLO Notes

Hemlock 28" N73°E 37 Links

Beech 12" S64°W 19 Links

Act 132 - Liber 1 Page 436 I.E. Chope April 1974 - Liber 2 Page 568 I.E. Chope July 1974  
Liber 2 Page 437 I.E. Chope April 1976

L.C.R.C. Forms - None

Unrecorded surveys - Sanilac Land Surveying Jan 1978 - Milletics Sept 1995

Description of corner evidence found and/or method applied in restoring or reestablishing corner:

C - 7


SE Corner Section 18 T11N-R16E

Found 1" Iron Bar in gravel Road Bed

West 2667.02 feet to the S 1/4 Corner Section 18

East 2657.68 feet to the S 1/4 Corner Section 17

Accepted as best evidence

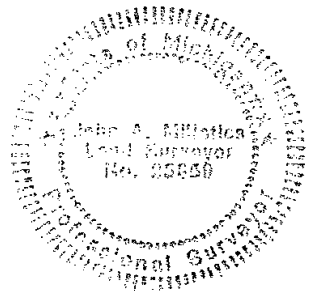

Description of monument for corner and accessories established to perpetuate locating the position of the corner:

C - 7

SE Corner Section 18 T11N-R16E

1" Iron Bar in gravel road bed

N75°W 103.90 feet to a nail in a 30" Pine

S50°W 77.60 feet to a nail in a Power Pole

S30°W 83.45 feet to a nail in a 18" Pine

S30°E 102.45 feet to a nail in a Power Pole

N70°E 49.30 feet to a Stop Sign

West 2667.02 feet to the S 1/4 Corner Section 18

East 2657.68 feet to the S 1/4 Corner Section 17

APPROVED PEER BOARD  
MEETING NOV 25 2000

*Signature*

signed by *John A. Milletics*

Date Nov 15, 2000

Surveyor's Michigan License No. 25859