

SURVEY & REMONUMENTATION

APR 14 1998

SECTION

For corners in ARGYLE

SANILAC

(County)

Located In:

Corner Code #

1. Public Land Survey

T13N R13E

E5

T13N R13E

D5

T R

T R

2. Property Controlling in Section

S

T R

S

T R

3. Miscellaneous Property in Sec.

S

T R

S

T R

4. Lot No. , Recorded Plat

5. Private Claims

I, John A. Millettics, in a field survey on Oct. 25 19 97 do hereby state that under requirements of P.A. 74, Michigan P.A. of 1970, the corner points mentioned in lines 1 and 2 above were in conformance with regulations and rules therefore as required in the current manual of survey instructions of the United States Department of the Interior, Bureau of Land Management or by a decree of a Court of Law and/or that the corner points mentioned in lines 3, 4 and 5 above were in conformance with the rules of the Michigan Board of Land Surveyors or by a Decree of a Court of Law; established, re-established, monumented, recovered, found as expressed below:

NOTE: Not more than 2 corners, all in the same town and range, may be recorded on this certificate.

A. Description of original monument and accessories and/or subsequent restoration:

E5

G.L.O. Notes Set Post Cor. Sec's. 8, 9, 16, and 17

Maple 12 S54E 20, Maple 10 N27E 26

Act 74 Form - None

Act 132 Form - L 3, Page 198, & L 3, Page 99

Road Commission Record - None

Drain Commission Record - None

D5

G.L.O. Notes Set quarter Section Post

Elm 9 N5W 10, Elm 7 S19E 11

Act 74 Form - None

Act 132 Form - L 3, Page 99

Road Commission Record - None

Drain Commission Record - None


B. Description of corner evidence found and/or method applied in restoring or reestablishing corner:

E5

Found 5/8" Re-Rod in Monument Box

D5

Found 1/2" Re-Rod in Monument Box

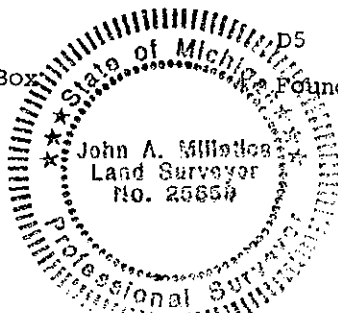

C. Description of monument for corner and accessories established to perpetuate locating the position of the corner:

E5

Cor. Sec's. 8, 9, 16 & 17, T13N-R13E

WITNESSES:

N45°E 44.22' to 1/2" Steel Stake

S50°E 83.98' to Spike S.W. Side 28" Ash

S45°W 100.68' to Spike N.W. Side 18" Ash

N45°W 44.98' to Notch W. End 72" CMP

East 2655.47' Apparent F5, T13N-R13E

West 2634.36' to D5, T13N-R13E

Found 5/8" Re-Rod in Monument Box

D5

1/4 Cor. Sec's. 8 and 17, T13N-R13E

Found 1/2" Re-Rod in Monument Box

WITNESSES:

N40°W 73.90' to Nail in 18" Maple

N15°W 49.75' to Nail in 12" Poplar

N30°E 65.14' to Nail in 15" Poplar

S30°W 50.50' to Nail in 8" Poplar

South 62.25' to Nail in 8" Ash

East 2634.36' to E5, T13N-R13E

West 2635.15' to C5, T13N-R13E

Signed by John A. Millettics

Surveyor's Michigan License No. 25859

Date Nov 12, 1997

PEER GROUP APPROVED

AT MEETING HELD

NOV. 26 1997

FORM APPROVED BY MICHIGAN STATE BOARD OF PROFESSIONAL SURVEYORS, JAN. 28, 1971  
REVISED MAY 14, 1975  
REVISED JAN., 1983  
REVISED OCT., 1995

RECEIVED FOR RECORD

97 DEC -2 AM 9:08

LIBER 2 PAGE 153

ESTHER LEE  
REGISTER OF DEEDS  
SANILAC CO., MICHIGAN

SURVEY & REMONUMENTATION

JAN 08 1998

Register of Deeds Section & File Number

