

MAR 15 2000

SECTION



ST. CLAIR COUNTY, MICHIGAN OFFICIAL GOVERNMENT CORNER

LAND CORNER RECORDATION CERTIFICATE
Filing Requirement of Act 74, Mich. P.A. 1970

CLERK REGISTER
ST. CLAIR COUNTY
RECEIVED FOR RECORD

DEC 22 1999

LIBER PAGE TIME 8:00 PM
Marilyn Dunn
MARILYN DUNN

Register of Deeds Stamp & File Number

Located In: CHINA TOWNSHIP Corner Code # H-1

1. Public Land Survey T 4N R 16E H-1
T R
2. Property Controlling S T R
in Section S T R
3. Miscellaneous S T R
Property in Sec. S T R

4. Lot No. , Recorded Plat
5. Private Claims

I, MICHAEL J. ROSSOW, in a field survey on AUGUST 10,
1999, do hereby certify that under requirements of P.A. 74, Michigan P.A.
of 1970, the corner points mentioned in lines 1 and 2 above were in
conformance with regulations and rules therefore as required in the current
manual of survey instructions of the United States Department of the Interior,
Bureau of Land Management or by a decree of a Court of Law and/or that the
corner points mentioned in lines 3, 4 and 5 above were in conformance with
the rules of the Michigan Board of Land Surveyors or by a Decree of a Court of
Law; established, re-established, monumented, re-monumented, recovered,
found as expressed below:

	A	B	C	D	E	F	G	H	I	J	K	L	M
2	6	5	4	3	2	1							
3													
4	7	8	9	10	11	12							
5													
6	18	17	16	15	14	13							
7													
8	19	20	21	22	23	24							
9													
10	30	29	28	27	26	25							
11													
12	31	32	33	34	35	36							
13													

NOTE: Not more than 1 CORNER, may be recorded on this certificate.

A. Description of original monument and accessories and/or subsequent restoration:

- H-13 ST. CLAIR TOWNSHIP, 1817, W. PRESTON OF GLO (SET AN 8" POST FOR CORNER)
- (A) 1972, J. LANSKY LCRC L.1, P.588 (FOUND & WITNESSED A 1/2" IRON ROD)
 - (B) 1974, C. ALLOWAY LCRC L.2, P.413 (FOUND & WITNESSED A 1/2" IRON PIPE)
 - (C) 1979, B. COLLINS LCRC L.5, P.73 (FOUND & WITNESSED A 1/2" IRON ROD)
 - (D) 1972, J. LANSKY SURVEY L.1, P.902 (DOES NOT ID CORNER, REFERS TO RECORDED CERTIFICATE FILED)
 - (E) 1982, J. LANSKY SURVEY L.8, P.335 (DOES NOT ID CORNER BUT REFERS TO LCRC L.1, P.588)
 - (F) ST. CLAIR COUNTY ROAD COMMISSION PLANS & WITNESSES BOOK
 - (G) 1994, J. NEIDERHAUSER UNRECORDED SURVEY (FOUND 1/2" IRON & WITNESSES THE SAME)
 - (H) 1996, J. NEIDERHAUSER UNRECORDED SURVEY (REFERS TO LCRC L.5, P.73)
 - (I) 1962, OLD ST. CLAIR COUNTY SURVEYOR RECORDS (FINDS & WITNESSES AN "IRON PIPE")
- SEE BACK OF SHEET

B. Description of corner evidence found and/or method applied in restoring or reestablishing corner:

FOUND A 1/2" IRON ROD USING THE WITNESSES & DATA FROM PART "A" ABOVE
3.5' NORTH OF NORTH EDGE OF PAVEMENT (A)(G)(I)
NORTH EAST 86.1' TO NAIL IN DETROIT EDISON POLE (A)(C)(F)(I)
SOUTH 3.55' TO NORTH EDGE OF PAVEMENT (A)(C)
39.90' NORTH WEST LAG SCREW IN FENCE POST (G)(J)(K)
38.65' NORTH LAG SCREW IN FENCE POST (G)(J)(K)
86.00' NORTH EAST TO PK IN UTILITY POLE (G)(J)(K)
51.75' SOUTH EAST TO CHISELED "X" IN 36" C.S.P. (G)(J)(K)


THIS CORNER IS COMMON TO H-13, ST. CLAIR TOWNSHIP, T.5N, R.16E.

PA 345-1990
PEER COMMITTEE
APPROVED 12-15-99

C. Description of monument for corner and accessories established to perpetuate locating the position of the corner:

SET A 2" DIAMETER ALUMINUM CAP WITH MAGNET ATTACHED & INSCRIBED "ST. CLAIR COUNTY OFFICIAL
CORNER" IN THE 1/2" IRON ROD WITH THE FOLLOWING WITNESSES:
WEST NORTH WEST 195.73' TO COUNTY TAG IN POWER POLE
NORTH NORTH WEST 39.94' TO COUNTY TAG IN 6" WOOD POST
NORTH EAST 85.89' TO COUNTY TAG IN POWER POLE
WEST SOUTH WEST 355.51 TO COUNTY TAG IN MBX POST

THE SELECTED LOCATION IS ACCEPTED BY ME AND IS GENERALLY ACCEPTED BY PROFESSIONAL
SURVEYORS AS THE BEST AVAILABLE EVIDENCE OF THE POSITION OF THE ORIGINAL CORNER.

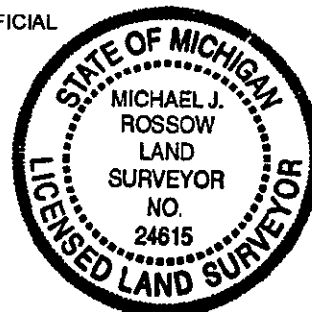

Signed by _____ Date 12-17-99

Surveyor's Michigan License No. 24615

SAC-000

BOOK 009 PAGE 341



ST. CLAIR COUNTY, MICHIGAN
OFFICIAL GOVERNMENT CORNER

SURVEY &
REMONUMENTATION

MAR 15 2000

SECTION

LAND CORNER RECORDATION CERTIFICATE
Filing Requirement of Act 74, Mich. P.A. 1970

	Located In:	Corner Code #
	CHINA TOWNSHIP	
1. Public Land Survey	T <u>4N</u> R <u>16E</u>	<u>H-1</u>
	T _____ R _____	_____
2. Property Controlling	S _____ T _____ R _____	_____
in Section	S _____ T _____ R _____	_____
3. Miscellaneous	S _____ T _____ R _____	_____
Property in Sec.	S _____ T _____ R _____	_____

Register of Deeds Stamp & File Number

H-1 CHINA TOWNSHIP, 1817, W. PRESTON OF GLO (SET AN 8" POST FOR CORNER)
(J) 1972, J. LANSKY LCRC L.1, P.588 (FOUND 1/2" IRON ROD & WITNESSED)
(K) 1994, J. NEIDERHAUSER LCRC L.8, P.12 (FOUND 1/2" IRON & WITNESSED)
(L) 1994, J. NEIDERHAUSER SURVEY L.14, P.351 (FOUND 1/2" IRON & WITNESSED)
(M) OLD ST. CLAIR COUNTY SURVEYOR RECORD (SHOWS NO CORNER)

