

ST. CLAIR COUNTY, MICHIGAN  
OFFICIAL GOVERNMENT CORNER



LAND CORNER RECORDATION CERTIFICATE  
Filing Requirement of Act 74, Mich. P.A. 1970

Located In: Corner Code ~~##~~

1. Public Land Survey Columbus Twp.  
T ~~5N.~~ R ~~15E.~~ M-1  
T \_\_\_\_\_ R \_\_\_\_\_  
T \_\_\_\_\_ R \_\_\_\_\_  
T \_\_\_\_\_ R \_\_\_\_\_  
T \_\_\_\_\_ R \_\_\_\_\_  
2. Property Controlling S \_\_\_\_\_ T \_\_\_\_\_ R \_\_\_\_\_  
in Section S \_\_\_\_\_ T \_\_\_\_\_ R \_\_\_\_\_  
3. Miscellaneous S \_\_\_\_\_ T \_\_\_\_\_ R \_\_\_\_\_  
Property in Sec. S \_\_\_\_\_ T \_\_\_\_\_ R \_\_\_\_\_

4. Lot No. \_\_\_\_\_, Recorded Plat \_\_\_\_\_  
5. Private Claims \_\_\_\_\_

I, **Daniel E. Johnson**, **Jan. 31**, **95**  
in a field survey on \_\_\_\_\_, 19\_\_\_\_\_,  
do hereby certify that under requirements of P.A. 74, Michigan P.A. of 1970, the corner points mentioned  
in lines 1 and 2 above were in conformance with regulations and rules therefore as required in the  
current manual of survey instructions of the United States Department of the Interior, Bureau of Land  
Management or by a decree of a Court of Law and/or that the corner points mentioned in lines 3, 4 and 5  
above were in conformance with the rules of the Michigan Board of Land Surveyors or by a Decree of a  
Court of Law; established, re-established, monumented, re-monumented, recovered, found as  
expressed below:

NOTE: Not more than 1 corner, may be recorded on this certificate.

- A. Description of original monument and accessories and/or subsequent restoration:

LIBER 007 PAGE 87

STATE PLAIN COORDINATES


N. \_\_\_\_\_

E. \_\_\_\_\_

ELEVATION \_\_\_\_\_

- B. Description of corner evidence found and/or method applied in restoring or reestablishing corner:

LIBER 007 PAGE 87

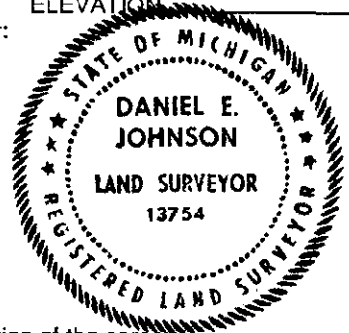

- C. Description of monument for corner and accessories established to perpetuate locating the position of the corner.  
Set 2" dia. aluminum cap inscribed "St. Clair County Official Corner"  
with magnet (in Monument Box) on a  
Concrete Monument (With Iron Rod Inserted)  
N.W. 43.57 Set PK Nail with County Tag in D.E. Pole  
N.E. 67.8 to center of Sun Pipe line marker  
S.E. 77.4 to N.W. Corner of N/S. Conc. Headwall  
S.W. 77.7 to N.E. Corner of N/S. Conc. Headwall

Note: Found Iron Rod 4.27 ft. SE'ly (Road P.I) ref.  
AD Plans No. 53 and 106

Signed by Daniel E. Johnson  
Daniel E. Johnson  
13754

Date January 31, 1995

Surveyor's Michigan License No. \_\_\_\_\_

PA 345-1990

PEER COMMITTEE

APPROVED 11-30-93 DW

APPROVED AS AN OFFICIAL GOVERNMENT CORNER BY ST. CLAIR COUNTY:

Signed By: Daniel E. Johnson  
St. Clair County Land Surveyor Daniel E. Johnson

7-31-95

LIBER 008 <sup>Date</sup> 93 PAGE

Surveyor's Michigan License No. 13754