

SURVEY &
REMONUMENTATION

DEC 02 1997

COMMISSION

ST. CLAIR COUNTY, MICHIGAN
OFFICIAL GOVERNMENT CORNER

LAND CORNER RECORDATION CERTIFICATE
Filing Requirement of Act 74, Mich. P.A. 1970



REGISTERED
ST. CLAIR COUNTY

DEC 21 AM 7:25

Located In: Corner Code #

1. Public Land Survey ST. CLAIR TWP.
T 5N R 16E H-1
T _____ R _____
2. Property Controlling S _____ T _____ R _____
in Section S _____ T _____ R _____
3. Miscellaneous S _____ T _____ R _____
Property in Sec. S _____ T _____ R _____

4. Lot No. _____, Recorded Plat _____

5. Private Claims _____

I, Michael J. Rossow, in a field survey on April 21,
1997, do hereby certify that under requirements of P.A. 74, Michigan P.A.
of 1970, the corner points mentioned in lines 1 and 2 above were in
conformance with regulations and rules therefore as required in the current
manual of survey instructions of the United States Department of the Interior,
Bureau of Land Management or by a decree of a Court of Law and/or that the
corner points mentioned in lines 3, 4 and 5 above were in conformance with
the rules of the Michigan Board of Land Surveyors or by a Decree of a Court of
Law; established, re-established, monumented, re-monumented, recovered,
found as expressed below:

Register of Deeds Stamp & File Number

	A	B	C	D	E	F	G	H	I	J	K	L	M
2	6	5	4	3	2	1							
3													
4	7	8	9	10	11	12							
5													
6	18	17	16	15	14	13							
7													
8	19	20	21	22	23	24							
9													
10	30	29	28	27	26	25							
11													
12	31	32	33	34	35	36							
13													

NOTE: Not more than 1 CORNER, may be recorded on this certificate.

A. Description of original monument and accessories and/or subsequent restoration:

A 5" HORNBEAM TREE WAS MARKED AS ORIGINAL CORNER, NO BEARING TREES RECITED (1817).
OLD ST. CLAIR COUNTY SURVEYOR'S RECORD WITNESSES A CORNER BUT DOES NOT DESCRIBE IT;
ALL WITNESSES DESTROYED (1942). ACT 74 CERTIFICATES FILED IN L.8,P.252 IDENTIFIES A
"T" IRON AS THE CORNER, WITNESSES VALID. ACT 74 CERTIFICATE FILED L.6,P.158 IS
MISFILED AND IS ACTUALLY CORNER H-13 IN T.6N.,R.16E.

B. Description of corner evidence found and/or method applied in restoring or reestablishing corner:

FOUND A "T" IRON PER ACT 74 CERTIFICATE FILED L.8,P.252
RECORDED WITNESSES: NE 59.25' TO PK & CAP IN D.E.P.; VERIFIED
SE 58.85' TO SPIKE & CAP IN COTTONWOOD; VERIFIED
147.41' WEST TO S. ¼ CORNER SEC. 34 T.6N.,R.16E.; VERIFIED

ACT 132 CERTIFICATES RECORDED IN L.2,P.656 AND L.15, P.504 CONTAIN NO LOCAL
WITNESSES.


PA 345-1990

PEER COMMITTEE

APPROVED 7-18-97

C. Description of monument for corner and accessories established to perpetuate locating the position of the corner:

SET A 2" DIA. ALUMINUM CAP WITH MAGNET ATTACHED & INSCRIBED "ST. CLAIR COUNTY
OFFICIAL CORNER" ON THE EXISTING "T" IRON AT THE CLOSING CORNER WHICH LIES 0.12'
NORTH OF AND NORMAL TO A LINE BETWEEN THE S. ¼ CORNER SEC. 33 AND THE S.E. CORNER
SEC. 33 T.6N.,R.16E.
161.70' WEST TO THE S. ¼ CORNER SECTION 34, T.6N.,R.16E.
58.99' ESE TO PK IN COUNTY TAG IN 24" COTTONWOOD
59.14' NE TO PK IN COUNTY TAG IN D.E. POLE
172.18' WSW TO PK IN COUNTY TAG IN 8" ELM
361.58' WNW TO PK IN COUNTY TAG IN D.E. POLE

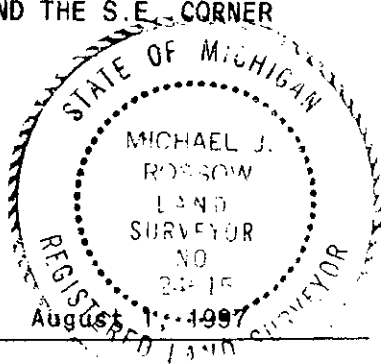

Signed by _____ Michael J. Rossow Date _____

Surveyor's Michigan License No. 24615