

ST. CLAIR COUNTY, MICHIGAN
OFFICIAL GOVERNMENT CORNER



LAND CORNER RECORDATION CERTIFICATE
Filing Requirement of Act 74, Mich. P.A. 1970

	Located In:	Corner Code #
	Berlin Twp.	
	6N 13E	B-1
1. Public Land Survey	T R	
	T R	
	T R	
	T R	
2. Property Controlling in Section	S T R	Seg #2
	S T R	
3. Miscellaneous	S T R	
Property in Sec.	S T R	

RECEIVED
1995 APR -4 AM 10:12
REGISTER OF DEEDS
ST. CLAIR COUNTY

Register of Deeds Stamp & File Number

4. Lot No. _____, Recorded Plat _____
5. Private Claims _____

	A	B	C	D	E	F	G	H	I	J	K	L	M
2	6	5	4	3	2								
3													
4	7	8	9	10	11	12							
5													
6	18	17	16	15	14	13							
7													
8	19	20	21	22	23	24							
9													
10	30	29	28	27	25	25							
11													
12	31	32	33	34	35	36							
13													

I, Daniel E. Johnson, in a field survey on February 8, 1995, do hereby certify that under requirements of P.A. 74, Michigan P.A. of 1970, the corner points mentioned in lines 1 and 2 above were in conformance with regulations and rules therefore as required in the current manual of survey instructions of the United States Department of the Interior, Bureau of Land Management or by a decree of a Court of Law and/or that the corner points mentioned in lines 3, 4 and 5 above were in conformance with the rules of the Michigan Board of Land Surveyors or by a Decree of a Court of Law; established, re-established, monumented, re-monumented, recovered, found as expressed below:

NOTE: Not more than 1 corner, may be recorded on this certificate.

- A. Description of original monument and accessories and/or subsequent restoration:

LIBER 007 PAGE 275

STATE PLAIN COORDINATES


N. _____

E. _____

ELEVATION _____

- B. Description of corner evidence found and/or method applied in restoring or reestablishing corner:

LIBER 007 PAGE 275

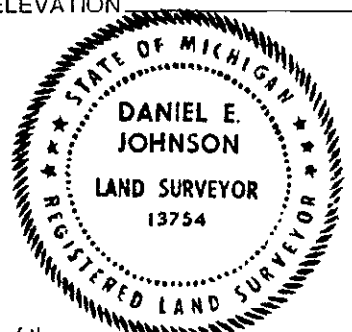

- C. Description of monument for corner and accessories established to perpetuate locating the position of the corner.
Set 2" dia. aluminum cap inscribed "St. Clair County Official Corner" with magnet
on a
1/2" Rebar set with I.D. #24615 Cap.

86.27' NW to set P.K. and County Tag in P. Pole.
36.42' SE to set P.K. and County Tag in Mail Box Post
86.15' SW to set P.K. and County Tag in GTE Pole.
395.90' ENE to set P.K. and County Tag in Guard Rail Post.

Signed by Daniel E. Johnson
Daniel E. Johnson
13754

Date February 8, 1995

Surveyor's Michigan License No. _____

PA 345-1990
PEER COMMITTEE

APPROVED 6-17-94 Daniel E. Johnson

APPROVED AS AN OFFICIAL GOVERNMENT CORNER BY ST. CLAIR COUNTY:

Signed By: Daniel E. Johnson
St. Clair County Land Surveyor Daniel E. Johnson
13754

Date 7-25-95

LIBER 008 PAGE 78