

ST. CLAIR COUNTY, MICHIGAN
OFFICIAL GOVERNMENT CORNER

LAND CORNER RECORDATION CERTIFICATE
Filing Requirement of Act 74, Mich. P.A. 1970



Located In: Corner Code #

1. Public Land Survey T 6N, R 15E, ---D-1---
T _____ R _____
T _____ R _____
T _____ R _____
2. Property Controlling S _____ T _____ R _____
in Section S _____ T _____ R _____
3. Miscellaneous S _____ T _____ R _____
Property in Sec. S _____ T _____ R _____

Seg 2

Register of Deeds Stamp & File Number

4. Lot No. _____, Recorded Plat _____
5. Private Claims _____


I, Daniel E. Johnson, in a field survey on April 17, 1995
do hereby certify that under requirements of P.A. 74, Michigan P.A. of 1970, the corner points mentioned
in lines 1 and 2 above were in conformance with regulations and rules therefore as required in the
current manual of survey instructions of the United States Department of the Interior, Bureau of Land
Management or by a decree of a Court of Law and/or that the corner points mentioned in lines 3, 4 and 5
above were in conformance with the rules of the Michigan Board of Land Surveyors or by a Decree of a
Court of Law; established, re-established, monumented, re-monumented, recovered, found as
expressed below:

NOTE: Not more than 1 corner, may be recorded on this certificate.

A. Description of original monument and accessories and/or subsequent restoration:

SEE LIBER 007 PAGE 175

	A	B	C	D	E	F	G	H	I	J	K	L	M
2	6		5	4		3		2		1			
3													
4	7		8	9		10		11		12			
5													
6	18		17	16		15		14		13			
7													
8	19		20	21		22		23		24			
9													
10	30		29	28		27		26		25			
11													
12	31		32	33		34		35		36			
13													

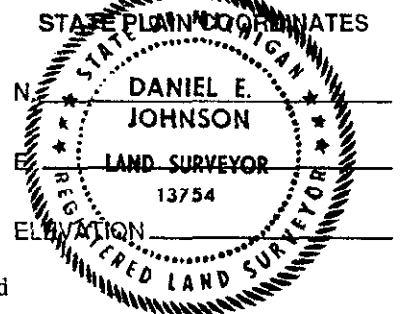

B. Description of corner evidence found and/or method applied in restoring or reestablishing corner:
Location of Corner fall in the center of 20' wide creek and could
not be set.

Reference point "A" is an aluminum cap on a "T" Iron and is 15.00' East of Corner and on the
North line section 5, T6N, R15E.

Reference point "B" is an aluminum cap on a "T" Iron and is 54.35' East of Corner and on the
North Line Section 5, T6N, R15E.

Corner was established on a line with the S $\frac{1}{2}$ Corner Section 32, T7N, R15E and the SE Corner
Section 32, T7N, R15E and at equal between the NW Corner Section 5, T6N, R15E and the
NE Corner Section 5, T6N, R15E

C. Description of monument for corner and accessories established to perpetuate locating the position of the corner:

Set 2" dia. Aluminum Cap inscribed "St. Clair County Official Corner" and stamped with
the Letter "A" over found "T" Iron #31596

N. 21.0' to set PK and County Tag in E face 12" Maple

NE 108.0' to set PK and County Tag in SW face of 12" Pine

SE 77.40' to set PK and County Tag in W face of 12" Ash

SSE 18.15' to set PK and County Tag in NE face of 12" Mulberry

Set 2" dia. Aluminum Cap inscribed "St Clair County Official Corner" and stamped with
the Letter "B: over found "T" Iron #31596

WNW 36.2' to set PK and County Tag in E face of 12" Maple

NE 74.65' to set PK and County Tag in SW face of 12" Pine

SE 51.50' to set PK and County Tag in W face of 12" Ash

Signed by SW 33.33' to set PK and County Tag in NE face of 12" Mulberry Date April 17, 1995

Surveyor's Michigan License No. Daniel E. Johnson #13754

PA 345-1990

PEER COMMITTEE

APPROVED 12-14-93 *Davis*

APPROVED AS AN OFFICIAL GOVERNMENT CORNER BY ST. CLAIR COUNTY:

Signed By: Daniel E. Johnson
St. Clair County Land Surveyor Daniel E. Johnson
#13754

Surveyor's Michigan License No. _____

Date 7-31-95
LIBER 008 PAGE 208