

ST. CLAIR COUNTY, MICHIGAN
OFFICIAL GOVERNMENT CORNER

LAND CORNER RECORDATION CERTIFICATE
Filing Requirement of Act 74, Mich. P.A. 1970



RECEIVED
REGISTER OF DEEDS
ST. CLAIR COUNTY
MICHIGAN
1995 MAY - 4 AM 10:14

Register of Deeds Stamp & File Number

Located In: Corner Code #

1. Public Land Survey T 7N R 14E C-13
T R
T R
T R
2. Property Controlling S T R
in Section S T R
3. Miscellaneous S T R
Property in Sec. S T R

4. Lot No. _____, Recorded Plat _____
5. Private Claims _____

I, Daniel E. Johnson, in a field survey on May 22, 1995, do hereby certify that under requirements of P.A. 74, Michigan P.A. of 1970, the corner points mentioned in lines 1 and 2 above were in conformance with regulations and rules therefore as required in the current manual of survey instructions of the United States Department of the Interior, Bureau of Land Management or by a decree of a Court of Law and/or that the corner points mentioned in lines 3, 4 and 5 above were in conformance with the rules of the Michigan Board of Land Surveyors or by a Decree of a Court of Law; established, re-established, monumented, re-monumented, recovered, found as expressed below:

NOTE: Not more than 1 corner, may be recorded on this certificate.

- A. Description of original monument and accessories and/or subsequent restoration:

LIBER 007 PAGE 345

STATE PLAIN COORDINATES


N. _____

E. _____

ELEVATION _____

- B. Description of corner evidence found and/or method applied in restoring or reestablishing corner:

LIBER 007 PAGE 345

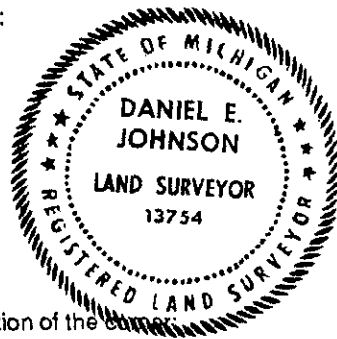

- C. Description of monument for corner and accessories established to perpetuate locating the position of the corner:

Set 2" Dia. Aluminum Cap inscribed "St. Clair County Official Corner" with magnet over 5/8" Rebar.

113.51' NW to P.K. and County Tag in P.Pole-1981 above F. P.K.
108.32' NE to P.K. and County Tag in P.Pole
125.40' SE to P.K. and County Tag in Willow
95.20' SW to P.K. and County Tag in P.Pole-below F. P.K.

Signed by Daniel E. Johnson Date May 22, 1995

Surveyor's Michigan License No. 13754

PA 345-1990

PEER COMMITTEE

APPROVED 5-20-94 Dave

APPROVED AS AN OFFICIAL GOVERNMENT CORNER BY ST. CLAIR COUNTY:

Signed By: Daniel E. Johnson : 7-31-95 Date

St. Clair County Land Surveyor Daniel E. Johnson

Surveyor's Michigan License No. 13754

LIBER 008 PAGE 96