

ST. CLAIR COUNTY, MICHIGAN
OFFICIAL GOVERNMENT CORNER



LAND CORNER RECORDATION CERTIFICATE
Filing Requirement of Act 74, Mich. P.A. 1970

Located In: Corner Code #

1. Public Land Survey T 7N R 14E D-13
T _____ R _____
T _____ R _____
T _____ R _____
2. Property Controlling S _____ T _____ R _____
in Section S _____ T _____ R _____
3. Miscellaneous S _____ T _____ R _____
Property in Sec. S _____ T _____ R _____

4. Lot No. _____, Recorded Plat _____
5. Private Claims _____

I, Daniel E. Johnson, in a field survey on May 22, 19 95
do hereby certify that under requirements of P.A. 74, Michigan P.A. of 1970, the corner points mentioned
in lines 1 and 2 above were in conformance with regulations and rules therefore as required in the
current manual of survey instructions of the United States Department of the Interior, Bureau of Land
Management or by a decree of a Court of Law and/or that the corner points mentioned in lines 3, 4 and 5
above were in conformance with the rules of the Michigan Board of Land Surveyors or by a Decree of a
Court of Law; established, re-established, monumented, re-monumented, recovered, found as
expressed below:

NOTE: Not more than 1 corner, may be recorded on this certificate.

A. Description of original monument and accessories and/or subsequent restoration:

LIBER 007 PAGE 343

B. Description of corner evidence found and/or method applied in restoring or reestablishing corner:

LIBER 007 PAGE 343

C. Description of monument for corner and accessories established to perpetuate locating the position of the corner:

Set 2" Dia. Aluminum Cap inscribed "St. Clair County Official Corner" with magnet
over 1/2" Rebar.

123.33' SE to set P.K. and County Tag in P.Pole
194.96' SW to set P.K. and County Tag in P.Pole
59.47' NNW to set P.K. and County Tag in 6" Maple
82.78' NE to set P.K. and County Tag in 6" Elm

Signed by Daniel E. Johnson

Daniel E. Johnson
13754

Surveyor's Michigan License No. _____

Date May 22, 1995

APPROVED AS AN OFFICIAL GOVERNMENT CORNER BY ST. CLAIR COUNTY:

Signed By: Daniel E. Johnson

St. Clair County Land Surveyor

Daniel E. Johnson

Surveyor's Michigan License No. 13754

REGISTERED
ST. CLAIR COUNTY
1995 AUG -4 AM 10:14
RECEIVED
Register of Deeds Stamp & File Number


	A	B	C	D	E	F	G	H	I	J	K	L	M
2	6	5	4	3	2	1							
3													
4	7	8	9	10	11	12							
5													
6	18	17	16	15	14	13							
7													
8	19	20	21	22	23	24							
9													
10	30	29	28	27	26	25							
11													
12	31	32	33	34	35	36							
13													

STATE PLAIN COORDINATES

N. _____

E. _____

ELEVATION _____

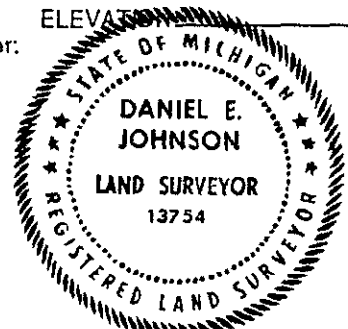

PA 345-1990

PEER COMMITTEE

APPROVED 5-20-94 Daniel

7-31-95

Date

LIBER 008 PAGE 97