

ST. CLAIR COUNTY, MICHIGAN
OFFICIAL GOVERNMENT CORNER

LAND CORNER RECORDATION CERTIFICATE
Filing Requirement of Act 74, Mich. P.A. 1970



Located In: Corner Code #

1. Public Land Survey T 7N R 15E F-13
T R
T R
T R
2. Property Controlling S T R
in Section S T R
3. Miscellaneous S T R
Property in Sec. S T R

RECEIVED
REGISTERED CLERK
ST. CLAIR COUNTY
MICHIGAN
DEC 29 AM 9:04

Register of Deeds Stamp & File Number

4. Lot No. , Recorded Plat
5. Private Claims

David J. Little in a field survey on October 6, 19 93
do hereby certify that under requirements of P.A. 74, Michigan P.A. of 1970, the corner points mentioned in lines 1 and 2 above were in conformance with regulations and rules therefore as required in the current manual of survey instructions of the United States Department of the Interior, Bureau of Land Management or by a decree of a Court of Law and/or that the corner points mentioned in lines 3, 4 and 5 above were in conformance with the rules of the Michigan Board of Land Surveyors or by a Decree of a Court of Law; established, re-established, monumented, re-monumented, recovered, found as expressed below:

NOTE: Not more than 1 corner, may be recorded on this certificate.

A. Description of original monument and accessories and/or subsequent restoration:
Post-(Government Surveys)

Nothing listed on Old Surveyor's Record St. Clair County.

No certificates filed on this corner.

B. Description of corner evidence found and/or method applied in restoring or reestablishing corner:
Set "T" Iron stamped LLS 31596.

Set "T" Iron on line with the Southeast Corner Section 33, T7N, R15E and the Southwest Corner Section 33, T7N, R15E and using found Iron Rod 0.62 North for East and West ties to Section Corners.


2159A000 12/29/93 MSSU4 9.00
0001
2159A000 12/29/93 SRF4 2.00
0001

Corner agrees with fence to the North, East and West

C. Description of monument for corner and accessories established to perpetuate locating the position of the corner:

NE 13.20' to set P.K. and County Tag in SW root of tri 60" Oaks
N. 23.20' to set P.K. and County Tag in E. face of 10" Wild Cherry
W. 35.85' to set P.K. and County Tag in S. face of 15" Maple.
SE 22.90' to set P.K. and County Tag in W. face of 10" Ash.

See attached sketch for additional information.

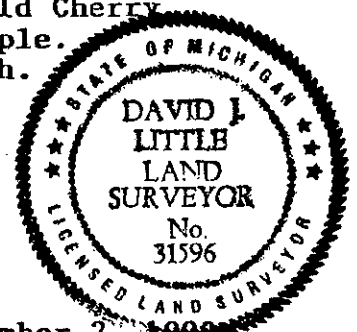

Signed by David J. Little
Surveyor's Michigan License No. 31596

Date December 2, 1993

PA 345-1990
PEER COMMITTEE

APPROVED 12-14-93

APPROVED AS AN OFFICIAL GOVERNMENT CORNER BY ST. CLAIR COUNTY:


Signed By: _____
St. Clair County Land Surveyor

Date

Surveyor's Michigan License No. _____

LIBER 007 PAGE 165

Certificate of Survey

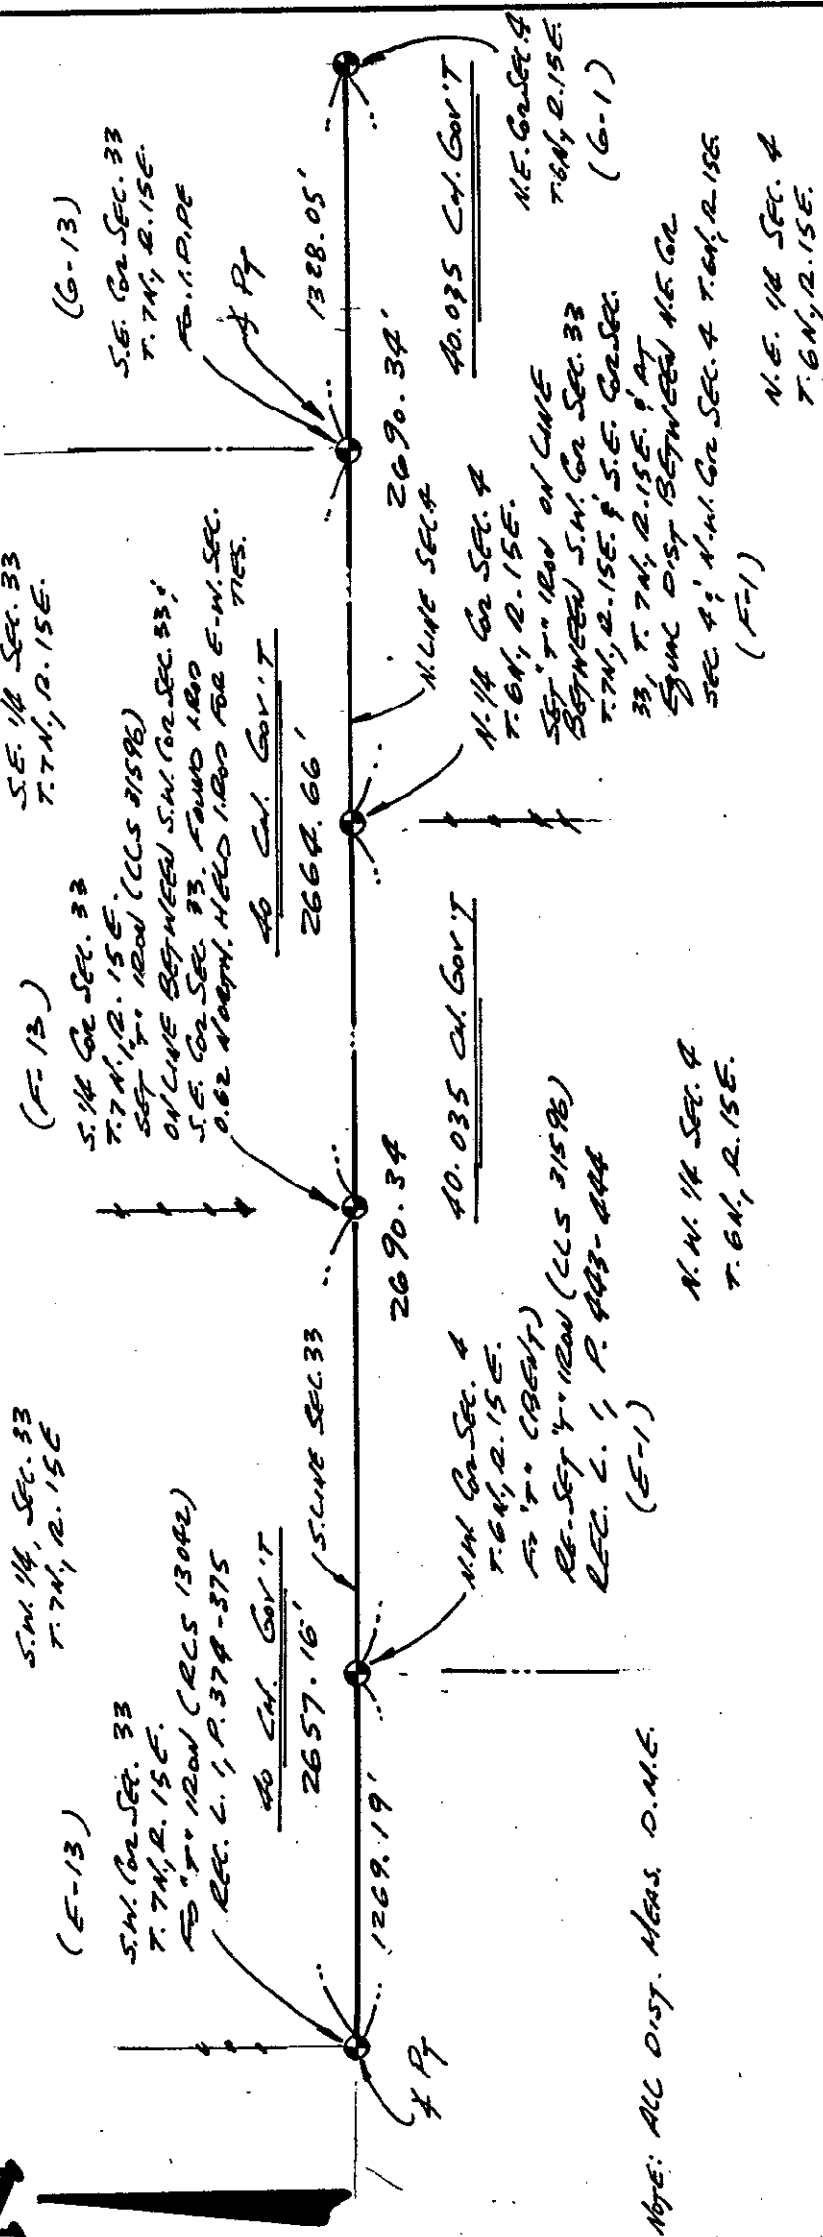

DAVID J. LITTLE
LICENSED LAND SURVEYOR
DEC. 2, 1993



DAVID J. LITTLE

2833 GRATIOT BOULEVARD, MARYSVILLE, MICHIGAN 48040
LICENSED LAND SURVEYORS

D.J.L.
12.2.93

93.147