

ST. CLAIR COUNTY, MICHIGAN
OFFICIAL GOVERNMENT CORNER



LAND CORNER RECORDATION CERTIFICATE
Filing Requirement of Act 74, Mich. P.A. 1970

Located In: Corner Code ##

1. Public Land Survey T 7N R 15E L-13
T _____ R _____
T _____ R _____
T _____ R _____
2. Property Controlling S _____ T _____ R _____
in Section S _____ T _____ R _____
3. Miscellaneous S _____ T _____ R _____
Property in Sec. S _____ T _____ R _____

4. Lot No. _____, Recorded Plat _____
5. Private Claims _____

Register of Deeds Stamp & File Number

I, David J. Little, in a field survey on October 18-20, 1993,
do hereby certify that under requirements of P.A. 74, Michigan P.A. of 1970, the corner points mentioned
in lines 1 and 2 above were in conformance with regulations and rules therefore as required in the
current manual of survey instructions of the United States Department of the Interior, Bureau of Land
Management or by a decree of a Court of Law and/or that the corner points mentioned in lines 3, 4 and 5
above were in conformance with the rules of the Michigan Board of Land Surveyors or by a Decree of a
Court of Law; established, re-established, monumented, re-monumented, recovered, found as
expressed below:

NOTE: Not more than 1 corner, may be recorded on this certificate.

A. Description of original monument and accessories and/or subsequent restoration:

Post--(Government Surveys)

Stone listed on Old Surveyor's Record
St. Clair County

No certificate filed on this corner.

B. Description of corner evidence found and/or method applied in restoring or reestablishing corner:

Found 1" Iron Pin in Monument Box 6" below road surface.

Corner verified with 1930 Michigan State Highway Department plans.

2159A000 12/29/93KSSU4 9.00-
0001

2159A000 12/29/93SSRE4 2.00
0001

C. Description of monument for corner and accessories established to perpetuate locating the position of the corner:

Iron Pin in Monument Box.

SW 70.2 to set P.K. and County Tag in NW face of D.E.P.
NW 127.47' to set P.K. and County Tag in W. face of D.E.P.
NE 55.40' to set P.K. and County Tag in W. face of D.E.P.
SE 149.80' to set P.K. and County Tag in N. face of D.E.P.
(Corner is on centerline of existing Lapeer Road pavement.)

See attached sketch for additional information.

Signed by David J. Little
Surveyor's Michigan License No. 31596

Date November 21, 1993



PA 345-1990
PEER COMMITTEE


APPROVED 12-7-93

APPROVED AS AN OFFICIAL GOVERNMENT CORNER BY ST. CLAIR COUNTY:

Signed By: _____ Date _____
St. Clair County Land Surveyor

Surveyor's Michigan License No. _____

Certificate of Survey

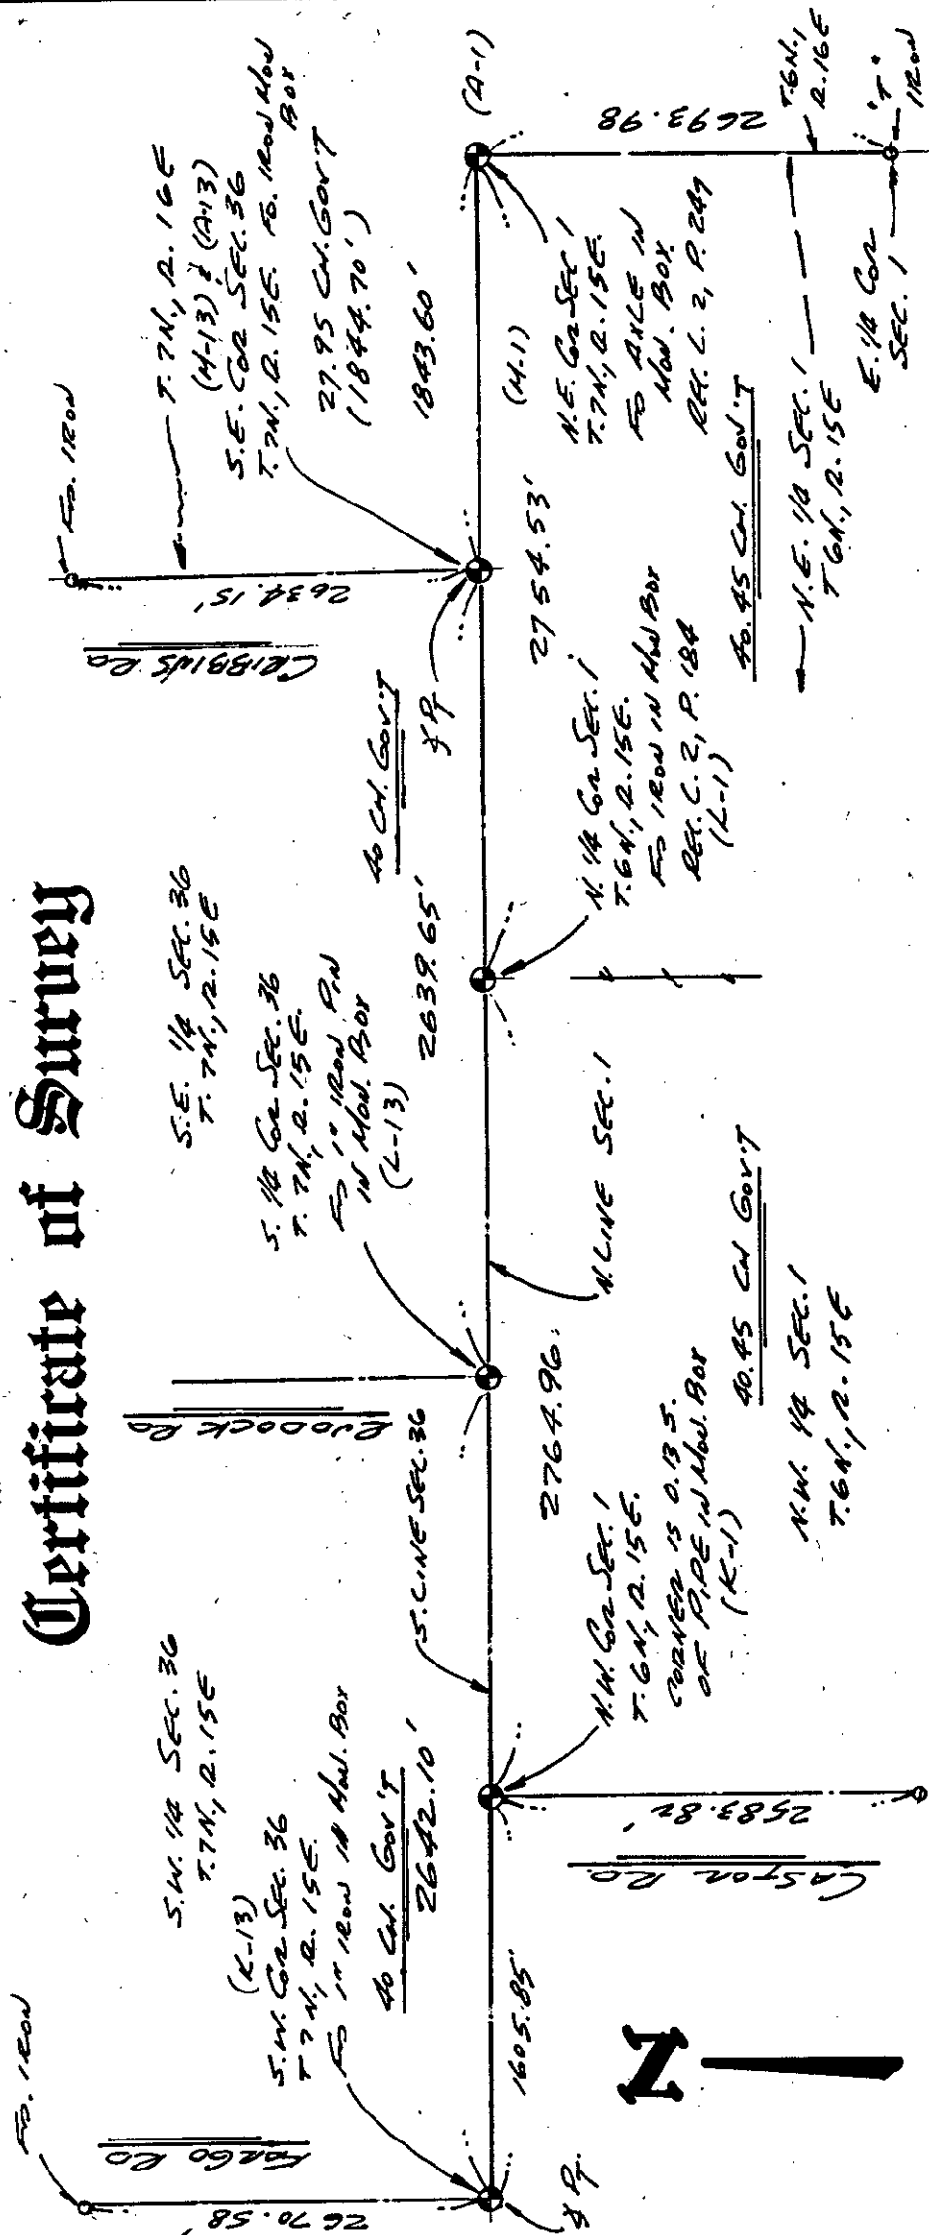

Note: ALL DIST.
MEAS. D.M.E.

DAVID J. LITTLE
LICENSED LAND SURVEYOR
NOVEMBER 23, 1993



DAVID J. LITTLE
2833 GRATIOT BOULEVARD, MARYSVILLE, MICHIGAN 48040
LICENSED LAND SURVEYORS

0.0	
1/4 600'	
11.23.93	93-147