

ST. CLAIR COUNTY, MICHIGAN
OFFICIAL GOVERNMENT CORNER

LAND CORNER RECORDATION CERTIFICATE
Filing Requirement of Act 74, Mich. P.A. 1970



Located In: Port Huron Twp. Corner Code #
7N 17E G-13 (Reference)

1. Public Land Survey T R
T R
T R
T R
2. Property Controlling S T R
in Section S T R
3. Miscellaneous S T R
Property in Sec. S T R

[Signature]

Register of Deeds Stamp & File Number

4. Lot No. , Recorded Plat
5. Private Claims

I, Daniel E. Johnson, in a field survey on May 11, 1995, do hereby certify that under requirements of P.A. 74, Michigan P.A. of 1970, the corner points mentioned in lines 1 and 2 above were in conformance with regulations and rules therefore as required in the current manual of survey instructions of the United States Department of the Interior, Bureau of Land Management or by a decree of a Court of Law and/or that the corner points mentioned in lines 3, 4 and 5 above were in conformance with the rules of the Michigan Board of Land Surveyors or by a Decree of a Court of Law; established, re-established, monumented, re-monumented, recovered, found as expressed below:

NOTE: Not more than 1 corner, may be recorded on this certificate.

- A. Description of original monument and accessories and/or subsequent restoration:

LIBER 007 PAGE 381

STATE PLAIN COORDINATES


N. _____

E. _____

ELEVATION _____

- B. Description of corner evidence found and/or method applied in restoring or reestablishing corner:

LIBER 007 PAGE 381

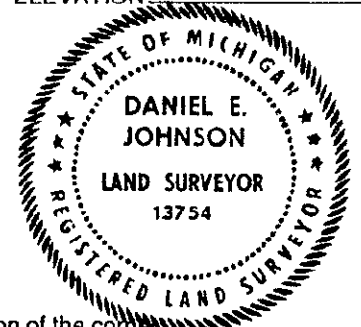

- C. Description of monument for corner and accessories established to perpetuate locating the position of the corner:
Set 2" dia. aluminum cap inscribed "St. Clair County Official Corner" with magnet on a 3/4" rerod at margin (west bank) of Black River on centerline of W Water St. extended. Located on the true Township line.
E.N.E. 35.08' to SW Corner of Detroit Edison Co. steel tower.
North 31.50' to W. end of a steel seawall.
South 47.60' to set PK Nail w/county remon tag in W side of guy pole.
S.E. 36.00' to S. end of a steel seawall.
West 2206.58' to S. 1/4 corner of Section 33, T7N-R17E
West 724.92' to 1/2" rerod in monument box on township line at Centerline of intersection of W. Water St. and Water Street.

Signed by *Daniel E. Johnson* Date May 11, 1995

Surveyor's Michigan License No. 13754

PA 345-1990
PEER COMMITTEE

APPROVED 6-10-94

APPROVED AS AN OFFICIAL GOVERNMENT CORNER BY ST. CLAIR COUNTY:

Signed By: *Daniel E. Johnson* : 7-31-95

St. Clair County Land Surveyor

13754

Date

Surveyor's Michigan License No. _____

LIBER 008 PAGE 165