

ST. CLAIR COUNTY, MICHIGAN OFFICIAL GOVERNMENT CORNER



LAND CORNER RECORDATION CERTIFICATE Filing Requirement of Act 74, Mich. P.A. 1970

Located In: _____ Corner Code # _____

Port Huron Twp.

- | | | | |
|------------------------------------|--------------------------|-------|--------------|
| 1. Public Land Survey | T <u>7N</u> R <u>17E</u> | D-13 | |
| | T _____ R _____ | _____ | _____ |
| | T _____ R _____ | _____ | _____ |
| | T _____ R _____ | _____ | _____ |
| 2. Property Controlling in Section | S _____ T _____ R _____ | _____ | <i>Sec 2</i> |
| | S _____ T _____ R _____ | _____ | |
| 3. Miscellaneous Property in Sec. | S _____ T _____ R _____ | _____ | |

RECEIVED
 REGISTER OF DEEDS
 ST. CLAIR COUNTY
 1995 AUG -4 AM 10:22
 Register of Deeds Stamp & File Number

4. Lot No. _____, Recorded Plat _____
5. Private Claims _____

	A	B	C	D	E	F	G	H	I	J	K	L	M
2	6		5		4		3		2		1		
3													
4	7		8		9		10		11		12		
5													
6	18		17		16		15		14		13		
7													
8	19		20		21		22		23		24		
9													
10	30		29		28		27		26		25		
11													
12	31		32		33		34		35		36		
13													

I, Daniel E. Johnson in a field survey on March 31, 1995
do hereby certify that under requirements of P.A. 74, Michigan P.A. of 1970, the corner points mentioned in lines 1 and 2 above were in conformance with regulations and rules therefore as required in the current manual of survey instructions of the United States Department of the Interior, Bureau of Land Management or by a decree of a Court of Law and/or that the corner points mentioned in lines 3, 4 and 5 above were in conformance with the rules of the Michigan Board of Land Surveyors or by a Decree of a Court of Law; established, re-established, monumented, re-monumented, recovered, found as expressed below:

NOTE: Not more than 1 corner, may be recorded on this certificate.

A. Description of original monument and accessories and/or subsequent restoration:

LIBER 007 PAGE 384

STATE PLAIN COORDINATES


N. _____

E. _____

ELEVATION _____

B. Description of corner evidence found and/or method applied in restoring or reestablishing corner:

LIBER 007 PAGE 384

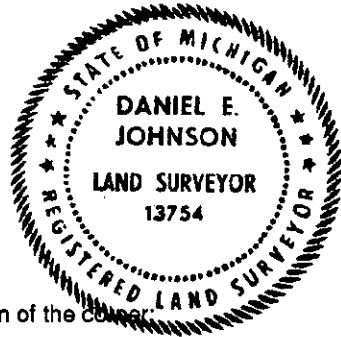

C. Description of monument for corner and accessories established to perpetuate locating the position of the corner:
 Set 1/2" x 18" Rerod with 2" dia. aluminum cap inscribed "St. Clair County Official Corner" with magnet (in Monument Box)
 on centerline of existing W Water St. Pavement.

Located on the true Township line
 N 75°E 125.32' to set PK nail w/county remon tag in NW side power pole
 S 60°E 81.99' to set PK nail w/county remon tag in NW side 30" Oak tree
 S 20°W 101.26' to set PK nail w/county remon tag in W side power pole
 N 05°E 32.60' to set PK nail w/county remon tag in W side power pole
 WEST 2637.01' to SW corner Section 32, T7N-R17E
 EAST 2618.49' to SE corner Section 32, T7N-R17E
 EAST 2666.43' to S 1/4 corner of Section 33, T7N-R17E

Signed by *Daniel E. Johnson* Date March 31, 1995
 Daniel E. Johnson
 Surveyor's Michigan License No. 13754

PA 345-1990
 PEER COMMITTEE
 APPROVED 6-10-94
Dunk

APPROVED AS AN OFFICIAL GOVERNMENT CORNER BY ST. CLAIR COUNTY:

Signed By: *Daniel E. Johnson* Date 7-31-95
 St. Clair County Land Surveyor Daniel E. Johnson
 13754
 Surveyor's Michigan License No. _____