

JAN 21 1999

SCHOOLCRAFT COUNTY PEER GROUP APPROVED

DATE 12/2/98 JOB

LAND CORNER RECORDATION CERTIFICATE
Filing Requirement of Act 74, Mich. P.A. 1970

SECTION

For corners in

Schoolcraft
(County)

Located In:

Corner Code #

SIGRID HEDBERG
SCHOOLCRAFT CO. REGISTER 1P
Page 1 of 1 LC 4/ 239
JLV Rec. Date 12/15/98 Time 14:21
REVENUE FEES: 9.00

1. Public Land Survey

T41N R16W I 2

2. Property Controlling
in Section

S T R

3. Miscellaneous
Property in Sec.

S T R

4. Lot No. _____, Recorded Plat _____
5. Private Claims _____

Register of Deeds Stamp & File Number

Thomas P. O'Brien, in a field survey on Dec. 11, 1998 do hereby state that under requirements of P.A. 74, Michigan P.A. of 1970, the corner points mentioned in lines 1 and 2 above were in conformance with regulations and rules therefore as required in the current manual of survey instructions of the United States Department of the Interior, Bureau of Land Management or by a decree of a Court of Law and/or that the corner points mentioned in lines 3, 4 and 5 above were in conformance with the rules of the Michigan Board of Land Surveyors or by a Decree of a Court of Law, established, re-established, monumented, recovered, found as expressed below:

NOTE: Not more than 2 corners, all in the same town and range, may be recorded on this certificate.

| | A | B | C | D | E | F | G | H | I | J | K | L | M |
|----|---|----|---|----|---|----|---|----|---|----|---|----|---|
| 1 | | | | | | | | | | | | | |
| 2 | | 6 | | 5 | | 4 | | 3 | X | 2 | | 1 | |
| 3 | | | | | | | | | | | | | |
| 4 | | 7 | | 8 | | 9 | | 10 | | 11 | | 12 | |
| 5 | | | | | | | | | | | | | |
| 6 | | 10 | | 17 | | 16 | | 15 | | 14 | | 13 | |
| 7 | | | | | | | | | | | | | |
| 8 | | 19 | | 20 | | 21 | | 22 | | 23 | | 24 | |
| 9 | | | | | | | | | | | | | |
| 10 | | 30 | | 29 | | 28 | | 27 | | 26 | | 25 | |
| 11 | | | | | | | | | | | | | |
| 12 | | 31 | | 32 | | 33 | | 34 | | 35 | | 36 | |
| 13 | | | | | | | | | | | | | |

A. Description of original monument and accessories and/or subsequent restoration:

- I2 W 1/4 Corner Section 2, T41N - R16W
Sept. 10, 1845 - John Burt D.S. set qr. section post referenced by:
Tamarack 6 N 67 W 18 Tamarack 5 S 12 E 14
Sept. 5, 1975 - LCRC (L.1 Pg.156) by Thomas P. O'Brien P.S. indicates
"Found post at intersection of fences North and East. Blazed lines South
and West. No GLO evidence. Distance checks well to North. Set iron bar
at base of post."
April 17, 1995 - LCRC (L.4 Pg.172) by Gerald W. Carlson.


B. Description of corner evidence found and/or method applied in restoring or reestablishing corner:

- I2 Dec. 11, 1998 - Thomas P. O'Brien P.S. recovered iron bar and broken
RLS 21274 cap. Witnesses found verify corner location as found by
Carlson 4/17/95. Reset iron bar with Schoolcraft County Monument
stamped to identify.

C. Description of monument for corner and accessories established to perpetuate locating the position of the corner:

- I2 Schoolcraft County Monument stamped to identify. Repainted blazes
on NBT's and made measurements to the following references:

9" Cedar - S54°E - 19.81'
8" Cedar - N54°W - 34.27'
6" W. Birch - N17°W - 19.77'
5" Cedar - N79°E - 30.43'
Carsonite post - North - 1.0'

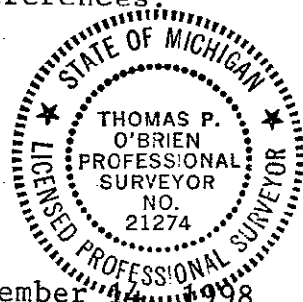

Signed by Thomas P. O'Brien

Date December 12, 1998

Surveyor's Michigan License No. 21274