

LAND CORNER RECORDATION CERTIFICATE
Filing Requirement of Act 74, Mich. P.A. 1970

For corners in

Schoolcraft

(County)

Located In:

Corner Code #

1. Public Land Survey	T	R	
	T	R	
	T	R	
	T	R	
2. Property Controlling in Section	S 31	T 41N	R 17W
	S 16	T 41N	R 17W
3. Miscellaneous Property in Sec.	S	T	R
	S	T	R

Register of Deeds Stamp & File Number

4. Lot No. _____, Recorded Plat _____
 5. Private Claims _____

2 May 01 2003
 3 Jun 03 2003

I, Stephan J. Szyzkoski, in a field survey on _____, 20____ do hereby state that under requirements of P.A. 74, Michigan P.A. of 1970, the corner points mentioned in lines 1 and 2 above were in conformance with regulations and rules therefore as required in the current manual of survey instructions of the United States Department of the Interior, Bureau of Land Management or by a decree of a Court of Law and/or that the corner points mentioned in lines 3, 4 and 5 above were in conformance with the rules of the Michigan Board of Land Surveyors or by a Decree of a Court of Law, established, re-established, monumented, recovered, found as expressed below:

	A	B	C	D	E	F	G	H	I	J	K	L	M
1													
2		6	5	4	3	2	1						
3													
4		7	8	9	10	11	12						
5													
6		18	17	16	15	14	13						
7													
8		19	20	21	22	23	24						
9													
10		30	29	28	27	26	25						
11													
12		31	32	33	34	35	36						
13													

NOTE: Not more than 2 corners, all in the same town and range, may be recorded on this certificate.

A. Description of original monument and accessories and/or subsequent restoration:
 (3-Sec. 31) North 1/16 corner between Sections 31 141N-R17W and 36 141N-R18W. Not established in the original survey. Found no subsequent record.

(2-Sec. 16) East 1/16 corner between Sections 9 and 16. Not established in the original survey.


B. Description of corner evidence found and/or method applied in restoring or reestablishing corner:

(3-Sec. 31) Found a 5/8" dia. rebar 0.04' N and 0.04' E of the midpoint between Section and Quarter corners north and south and accepted same. The corner lies approximately 15' east of a road.

(2-Sec. 16) Established the corner midway and on a line of mean true bearing between Section corner 1325.82' ft. east and Quarter corner 1325.82' west.

C. Description of monument for corner and accessories established to perpetuate locating the position of the corner:

- | | |
|--|--|
| (3) Set plastic cap "MICH DNR PS 33986" on found 5/8" dia. rebar. Blazed, scribed, and set measuring nails in: | (2) Set 5/8"x24" rebar with plastic cap "MICH DNR PS 33986". Placed nails with plastic ID tags in: |
| 5" Balsam S42E 15.65' | 8" Maple S63W 65.9' |
| 5" Balsam S12W 17.75' | 6" Maple S38W 42.6' |
| 6" Cedar S31E 52.8' | 6" Elm S37E 44.05' |
| 10" N. Birch S82W 71.4' | 6" Maple N11E 41.4' |
- Bearings are magnetic. Distances are to nail with tag.
 Bearings are magnetic. Distances are horizontal and to nail with tag in the side of 81.

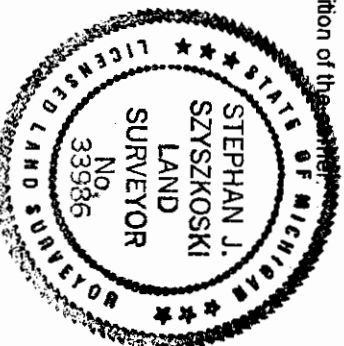

Signed by Stephan J. Szyzkoski Date 6/16/03
 Surveyor's Michigan License No. 33986