

LAND CORNER RECORDATION CERTIFICATE
Filing Requirement of Act 74, Mich. P.A. 1970

For corners in

Schoecraft

(County)

Located In:

Corner Code #

1. Public Land Survey

T__R__
T__R__
T__R__
T__R__

2. Property Controlling

S__3L__ T__41N__ R__17W__
S__3L__ T__41N__ R__17W__
S__ T__ R__

3. Miscellaneous

S__ T__ R__
S__ T__ R__
S__ T__ R__

Property in Sec.

Register of Deeds Stamp & File Number

4. Lot No. _____, Recorded Plat _____

5. Private Claims _____

Jun 03 2003

I, Stephan J. Szyzkoski, in a field survey on 20 do hereby state that under requirements of P.A. 74, Michigan P.A. of 1970, the corner points mentioned in lines 1 and 2 above were in conformance with regulations and rules therefore as required in the current manual of survey instructions of the United States Department of the Interior, Bureau of Land Management or by a decree of a Court of Law and/or that the corner points mentioned in lines 3, 4 and 5 above were in conformance with the rules of the Michigan Board of Land Surveyors or by a Decree of a Court of Law; established, re-established, monumented, recovered, found as expressed below:

NOTE: Not more than 2 corners, all in the same town and range, may be recorded on this Certificate.


1	A	B	C	D	E	F	G	H	I	J	K	L	M
2	6	5	4	3	2	1							
3													
4	7	8	9	10	11	12							
5													
6	18	17	16	15	14	13							
7													
8	19	20	21	22	23	24							
9													
10	30	29	28	27	26	25							
11													
12	31	32	33	34	35	36							

A. Description of original monument and accessories and/or subsequent restoration:
(2-Sec. 31) East 1/16 corner between Sections 30 and 31. Not established in the original survey. found no subsequent record.
(5-Sec. 31) North 1/16 corner, Section 31. Not established in the original survey.

B. Description of corner evidence found and/or method applied in restoring or reestablishing corner:

(2-Sec. 31) Found a 3/4" ID iron pipe placed by an unknown surveyor 1.0' east and 0.7' south of a position midway and on line between Section and Quarter corners. Accepted same.
(5-Sec. 31) Established the corner midway and on a straight line between Quarter corner and Center of Section 314.65' north and south.

C. Description of monument for corner and accessories established to perpetuate locating the position of the corner:
(2) Fd. 3/4" ID iron pipe. Blazed, scribed, and set measuring nails in:
10" Hemlock S36W 6.65' "E1/16 81"
6" Maple S29E 22.3' do
5" Spruce M48E 2.55' do
6" Spruce N08W 7.3' do
Steel fence post is S30W 0.8'
Bearings are magnetic. Distances are to nail with tag.
(5) Set 1" IDx36" I. pipe with 4" alum. HONR cap. Blazed, scribed, and set measuring nails in:
5" triple M. Pine S59E 43.95' "N1/16 81"
5" M. Pine S12W 47.5' do
Set measuring nails/tags in but did not blaze or scribe the following:
4" M. Birch N16W 44.0'
8" Cherry N57W 35.7'
Bearings are magnetic. Distances are to nail with tag.

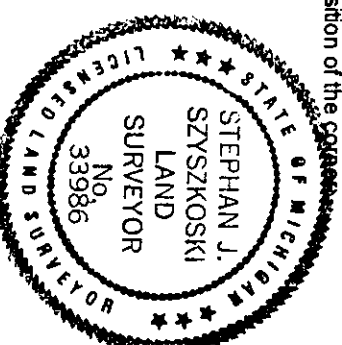

Signed by Stephan J. Szyzkoski
Surveyor's Michigan License No. 33986

Date 6/16/03

For the Michigan Department of Natural Resources - Office of Land and Facilities

FORM APPROVED BY MICHIGAN STATE BOARD OF PROFESSIONAL SURVEYORS, JAN 28, 1971

REVISED MAY 14, 1975
REVISED JAN, 1983
REVISED OCT., 1995