

SCHOOLCRAFT COUNTY
PEER GROUP APPROVED

DATE 11/8/99 JTB

LAND CORNER RECORDATION CERTIFICATE
Filing Requirement of Act 74, Mich. P.A. 1970

JAN 25 2000

SECTION

For corners in

Schoolcraft
(County)

Located In:

Corner Code #

SIGRID HEDBERG

SCHOOLCRAFT CO. REGISTER

1P

Page 1 of 1

JL Date 12/22/1999

LC 4/294

Time 13:50:30

RECORDING FEES:

9.00

1. Public Land Survey

T 41N R 15W

B3

2. Property Controlling
in Section

S

T

R

3. Miscellaneous
Property in Sec.

S

T

R

S

T

R

4. Lot No. , Recorded Plat

5. Private Claims

Register of Deeds Stamp & File Number

I, Thomas P. O'Brien in a field survey on Nov. 22, 1999 do hereby state that under requirements of P.A. 74, Michigan P.A. of 1970, the corner points mentioned in lines 1 and 2 above were in conformance with regulations and rules therefore as required in the current manual of survey instructions of the United States Department of the Interior, Bureau of Land Management or by a decree of a Court of Law and/or that the corner points mentioned in lines 3, 4 and 5 above were in conformance with the rules of the Michigan Board of Land Surveyors or by a Decree of a Court of Law; established, re-established, monumented, recovered, found as expressed below:

NOTE: Not more than 2 corners, all in the same town and range, may be recorded on this certificate.

A. Description of original monument and accessories and/or subsequent restoration:

Sept. 8, 1845 J. Burt, DS set qr. section post Cedar 6 N9W 22 Do 10 N71E 12

April 20, 1995 Sundberg, Carlson and Associates found a 1" O.D. pipe with Davis 16926 cap and witnesses trees. Added nails to witness trees.

B. Description of corner evidence found and/or method applied in restoring or reestablishing corner:

Nov. 22, 1999 Thomas P. O'Brien, PS restored corner from witness trees. Distances East and West indicate corner was set by proportionate measurement between A3 and C3.

C. Description of monument for corner and accessories established to perpetuate locating the position of the corner:

$\frac{1}{2}$ " iron bar w/O'BRIEN 21274 cap set in R/R bed 2.68'S. of S. rail

Witnesses:


14" White Birch S43°E 60.13'

12" Twin White Birch S40°W 57.92'

6" White Birch S64°W 51.03'

Chisled x on s. side s. rail N4°E 2.68'

Carsonite Post South 20.0'

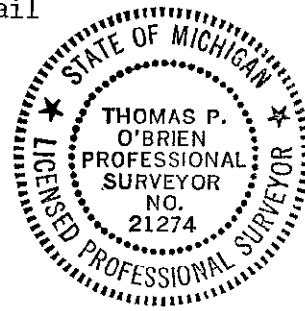

Signed by Thomas P. O'Brien

Date Dec. 16, 1999

Surveyor's Michigan License No. 21274