

LAND CORNER RECORDATION CERTIFICATE
Filing Requirement of Act 74, Mich. P.A. 1970

SURVEY & MONUMENTATION

For corners in

Located in:

Corner Code #

JAN 16 2001

SECTION

Register of Deeds Stamp
& File Number

Shiawassee
(County)

1. Public Land Survey

T	7N	R	3E	L-3
T		R		
T		R		
T		R		
S	T	R		
S	T	R		
S	T	R		
S	T	R		

2. Property Controlling
In Section

3. Miscellaneous
Property in Sec.

4. Lot No.

5. Private Claims

I, Mark L. VanRaemdonck, in a field survey on, January 5, 2000, do hereby certify that under requirements of P.A. 74, Michigan P.A. of 1970, the corner points mentioned in lines 1 and 2 above were in conformance with regulations and rules therefore as required in the current manual of survey instructions of the United States Department of the Interior, Bureau of Land Management or by a decree of a Court of Law and/or that the corner points mentioned in lines 3, 4 and 5 above were in conformance with the rules of the Michigan Board of Land Surveyors or by a Decree of a Court of Law; established, re-established, monumented, re-monumented, recovered, found as expressed below:

NOTE: Not more than 2 corners, all in the same town and range, may be recorded on this certificate.

A. Description of original monument and accessories and/or subsequent restoration:

1.) Original, Joseph Wampler, D.S., April 1822.

Monument: Wood Post

Accessories: W. Oak 36 N64W 17
Elm 10 N28½ E 14

2.) Lyman Mason, County Surveyor, County Surveyor's Book C, page 92-93,
December 6, 7 and 8, 1875.

Monument: Not given

Accessories: Elm 10 N45E 90
S. Maple 16 S69¼ W 120¼
West 39.95 CH (2636.7') to corner K-3
East 39.95 CH (2636.7') to corner M-3

3.) H.C. Main, County Surveyor, County Surveyor's Book E, page 156-157, November 29 and 30,
1886.

Monument: Not given

Accessories: S. Maple 7 N36½ E 65¼
Butterwood N15E 70
Ne cor., Sec. 12 East 39.96 (2637.36')

4.) Jan S. Fokens, Certified Survey, recorded Liber 2, page 357, August 24, 1976.

Monument: Not given

Accessories: No witnesses give.

N69°26'35"E 2635.98 to M-3
S89°26'35"W 2635.78 to K-3

5.) Mark L. VanRaemdonck, certified survey, recorded Liber 6, page 514, July 12, 1993.

Monument: Found rerod and cap #11192

Accessories: South 14.0' CL asphalt road
S30°E 38.33' S. end 36" CMP
N60°E 28.08' N. end 36" CMP
N30°E 23.16' NE end 24" CMP

Continued on reverse.

B. Description of corner evidence found and/or method applied in restoring or re-establishing corner:
Searched the apparent corner location and found a rerod with cap No. 11192 as referenced in No. 4 and No. 5 above. Found this point to be within 0.07 feet of being at mid-point and on line between corners K-3 and M-3. This location also agrees very close (within 0.85') with the L. Mason survey as shown in No. 2 above as well as the G.L.O. Accepted this location as the original corner position based on the best available evidence.


C. Description of monument for corner and accessories to perpetuate locating the position of the corner:
Replaced the rerod and cap #11192 with a standard Shiawassee County Harrison marker monument. The marker is stamped "Ramon P.S. 24622" and is witnessed by the following accessories:

South 32.72'	N. edge 3" diameter metal tube
S25°E 38.22'	Top cen. S. end 36" CMP
N40°E 28.28'	Top cen. N. end 24" CMP
N45°W 11.63'	Top cen. SW end 24" CMP
South 14.40'	CL Wilkinson Road

APPROVED

County Remonumentation
Peer Review Group

NCC
13 NOV 00

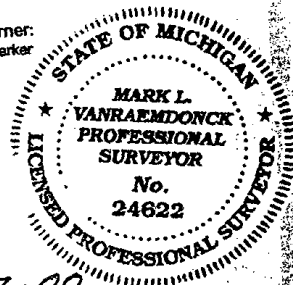

Signed by

Surveyor's Michigan License No. 24622

Date 10-17-00



3043876

Page: 1 of 2
11/17/2000 09:33A
1-1 6-120

FORM APPROVED BY MICHIGAN STATE BOARD OF LAND SURVEYORS JAN 18, 1974
REVISED MAY 14, 1975
REVISED JAN, 1983

A. Description of original monument and accessories and/or subsequent restoration:

6.) Mark L. VanRaemdonck, unrecorded survey, April 24, 1997.

Monument: Found REI rerod and cap

Accessories: None given


7.) Mark L. VanRaemdonck, Certified Survey, recorded Liber 8, page 101, December 5, 1997.

Monument: Found rerod and cap #11192

Accessories: Same as No. 5 above.

8.) Mark L. VanRaemdonck, Certified Survey, recorded Liber 8, page 483, June 2, 1999.

Monument and accessories are the same as No. 5 above.

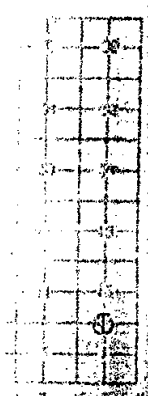

3043876

Page: 2 of 2
11/17/2000 09:33A

L-1 P-329

Kaye Grubba - Shawassee Co.

REMON

RECORDS SECTION
NOV 20 2000