

SECTION

1999 REMONUMENTATION PROGRAM  
LAND CORNER RECORDATION CERTIFICATE  
Filing Requirement of Act 74, Mich. P.A. 1970

For corners in



3026106  
Page: 1 of 1  
10/05/1999 02:19P  
L-1 P-299

Keya Grubba - Shiawassee Co. REMON

Shiawassee  
(County)

Located in:  
New Haven Twp

Corner Code #

1. Public Land Survey T8N R3E M-8  
T R  
2. Property Controlling S T R  
in Section S T R  
3. Miscellaneous S T R  
Property in Sec. S T R

Register of Deeds Stamp & File Number

4. Lot No. \_\_\_\_\_ Recorded Plat \_\_\_\_\_  
5. Private Claims \_\_\_\_\_

APPROVED  
County Remonumentation  
Peer Review Group  
10 OCT 99  
NCC

I, John H. Rauser, P.S., in a field survey on August 30 1999, do hereby certify that under requirements of P.A. 74, Michigan P.A. of 1970, the corner points mentioned in lines 1 and 2 above were in conformance with regulations and rules therefore as required in the current manual of survey instructions of the United States Department of the Interior, Bureau of Land Management or by a decree of a Court of Law and/or that the corner points mentioned in lines 3, 4 and 5 above were in conformance with the rules of the Michigan Board of Land Surveyors or by a Decree of a Court of Law; established, re-established, monumented, re-monumented, recovered, found as expressed below:

NOTE: Not more than 2 corners, all in the same town and range, may be recorded on this certificate.

	A	B	C	D	E	F	G	H	I	J	K	L	M
1													
2	6	5	4	3	2	1							
3													
4	7	8	9	10	11	12							
5													
6	18	17	16	15	14	13							
7													
8	19	20	21	22	23	24							
9													
10	30	29	28	27	26	25							
11													
12	31	32	33	34	35	36							
13													

A. Description of original monument and accessories and/or subsequent restoration:

- M-8 Standard 1/4 Corner, Section 24, T8N-R3E, New Haven Township, Shiawassee County  
1822 Wood post placed by J. Wampler, D.S., Elm 18" N20E 37lks (24.42')  
Lynn 7" S16W 27lks (17.82')  
1894 County Survey by H.C. Main, C.S. survey of Section 19, T8N-R4E, calls for the 1/4 of Section 24, T8N-R3E, South 58 1/2 lks. (38.61')  
1919 County Drain Record, Road Book 28, Page 30, Found large stone, Hickory 6" S31°40'E, 47.3'; Hickory 10" S65°30'E, 33'  
1998 Act 132 by J.H. Rauser, P.S. 39096, found 1/2" rod witnessed by N30E, 50.81' fnd 1/2" rod on ditch bank; N80E 25.03' fnd 1/2" rod on ditch bank; S80W 19.96' fnd 1/2" rod on ditch bank; N40W 32.15' fnd 1/2" rod on ditch bank.


B. Description of corner evidence found and/or method applied in restoring or reestablishing corner:

- M-8 Standard 1/4 Corner, Section 24, T8N-R3E, New Haven Township, Shiawassee County  
Found no evidence of original government accessories or county survey accessories. Found 1/2" re-rod with cap #24622 at the approximate split of the distance between M-9 and M-7, T8N-R3E. Found no conflicting evidence in the vicinity of this position. Measured South to M-9 = 2628.77' and North to M-7 = 2628.92'. Measured North to the found 1/2" iron and cap #24622, at the Closing 1/4 corner to Section 19, T8N-R4E = 32.32' (County surveyor 1894 = 58 1/2 lks, 38.61'), in line with occupation to the East. No evidence of occupation to the West at this position due to corn field North and South of the 1/4 line. We recommend accepting the found 1/2" re-rod with cap #24622 as the best available evidence of the position of the original government corner and place a standard Shiawassee County Harrison monument 0.5' below grade at this position.

C. Description of monument for corner and accessories established to perpetuate locating the position of the corner:

- M-8 Standard 1/4 Corner, Section 24, T8N-R3E, New Haven Township, Shiawassee County  
Set a standard 20" Harrison monument and monument box at the position approved by the Shiawassee County Peer Review Group, 0.6' below grade.  
N30°E 50.80' Found 1/2" rod on ditch bank  
N80°E 25.03' Found 1/2" rod on ditch bank  
S80°W 19.98' Found 1/2" rod on ditch bank  
N40°W 32.15' Found 1/2" rod on ditch bank

Signed by John H. Rauser  
Surveyor's Michigan License No. 39096

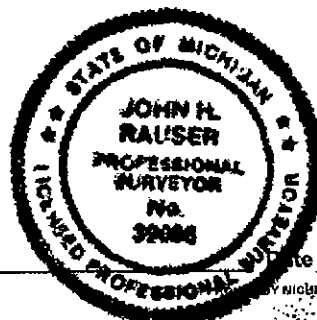

9/9/99