MAR 0 5 1998


1997 REMONUMENTATION PROGRAM

RECEIVED	FOR	RECOR	D _
LIBER NO	Pλ	GF NO	81

100.	1237 REMORBILITY TON TROUB	LIBER NOPAGE NO SI
SECTION For corners in Indianfields Twp.	LAND CORNER RECORDATION CERT Filing Requirement of Act 74, Mich. P.	A. 1970 FINOV-5 PH 4:01
7	0	31 MO3 -2 PH 4: 01
(County) Located Ir	n: Corner Code #	Genzy-Milyen
1. Public Land Survey T	T <u>2N R 09E B-13</u> R R R R R R R R R R R R R R R R R R R	TUSCOLA COUNTY REGISTER OF DEEDS
2. Property Controlling S T I I I I I I I I I I I I I I I I I I	R R R R R R R R R R R R R R R R R R R	Register of Deeds Stamp & File Number
4. Lot No. Recorded Plat		
4. Lot No, Recorded Plat 5. Private Claims		1 B C D E F G H I J K L 2 6 - 5 - 4 - 3 - 2 - 1
requirements of P.A. 74, Michigan P.A. of 1970,	urvey on Aug. 16, 19 97 do hereby state that u the corner points mentioned in lines 1 and 2 above we	re in _
United States Department of the interior, Bureau of that the corner points mentioned in lines 3, 4 and	as required in the current manual of survey instructions o of Land Management or by a decree of a Court of Law an if 5 above were in conformance with the rules of the Mich a Court of Law; established, re-established, monumer	d/or 6 18 17 16 15 14 13
NOTE: Not more than 2 corners, all in the son this certificate.	ame town and range, may be recorded	9
	% .	11
R9E. S 1/4 cor. prev. set. witness card, E. C. Parker, Stone corner had been found 67.07' tacked hub stake, S33 #79041C. Object and accesso unrecorded by Rowe, L.S. #11 Sec. A con't. on back of for B. Description of corner evidence found a Found 3/8" pipe in monument be	C. P. glass & crockery at corner Survey Chief, set 3/8" pipe from by Gar. Steadman, Survey Chief is E 60.39' tacked hub stake. 1961 ries same as 1960 witness card the 192. Found 3/8" pipe in monumer m. and/or method applied in restoring or reestablishing ox and three accessories that in	in 1932, NO9°W 52.63' p.p., S42°W L-62 M.S.H.D. plans sheet 16, project py Parker. June 29, 1971 Survey at box.
		·
Placed standard brass cap ove Encased cap in concrete in mo NlO°W 77.ll' fnd. bottle cap North 75.33' chiseled "+" ato East 147.21' fnd. 3/4" sq. in	onument box. in S. face p. pole, set remon. op conc. R.O.W. marker. ron in monument box. Apparent C	ox. Stamped cap B-13, T12N-R9E. tag & spike above.
Signed bySurveyor's Michigan License No235	APPROVED APPE	KENNETH D. DUNTON LAND SURVEYOR No. 23503
	0-20-97 BB FORM APPROVED BY I	MICHIGAN STATE BOARD OF PROFESSIONAL SURVEYORS, AME 28, 16 REVISED MAY 14,16 REVISED JAN., 16 REVISED OCT., 16

Section A con't from front of form:

North 75.4' conc. R.O.W. marker (top center), N10°W 77.12' nail & cap in p.p., S40°W 84.46' steel fence post. Sept. 1971 L.C.R.C. Page 18 by Rowe, L.S. #11192. Object and accessories same as June 1971 survey. March 6, 1972 survey L-1, P-475 & 476 by Rowe, L.S. #11192. Same object and accessories as Sept. 1971 L.C.R.C. April 22, 1974 L-440, P-28 by Kay, L.S. #1409 No object stated or accessories. Nov. 10, 1978 survey L-494, P-472 & 473 by Rowe, L.S. #1111 No object stated or accessories. Corner is shown 0.30' south of E-W highway centerline. June 30, 1988 survey L-583, P-1233 by Dunton, L.S. #23503. Same object and accessories as shown on 1971 L.C.k.C.

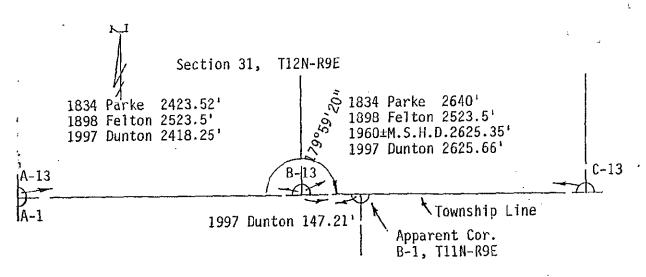

Section 6, T11N-R9E