

**Filing Requirement of Act 74, Mich. P.A. 1970
1995 REMONUMENTATION PROGRAM**

TUSCOLA
(County)

Corner Code #

1. Public Land Survey	T	12N	R	09E
	T		R	
	T		R	
	T		R	
2. Property Controlling in Section	S	T	R	
	S	T	R	
3. Miscellaneous Property in Sec.	S	T	R	
	S	T	R	

H-3

4. Lot No. _____, Recorded Plat _____
5. Private Claims _____

I, JONATHAN M. FIELD, in a field survey on SEPTEMBER 1, 1995
do hereby certify that under requirements of P.A. 74, Michigan P.A. of 1970, the corner points mentioned
in lines 1 and 2 above were in conformance with regulations and rules therefore as required in the
current manual of survey instructions of the United States Department of the Interior, Bureau of Land
Management or by a decree of a Court of Law and/or that the corner points mentioned in lines 3, 4 and 5
above were in conformance with the rules of the Michigan Board of Land Surveyors or by a Decree of a
Court of Law; established, re-established, monumented, re-monumented, recovered, found as
expressed below:


NOTE: Not more than 4 corners, all in the same town and range, may be recorded on this certificate.

[illegible]

1835 GLO; RISDON, D.S.; SET POST; HEMLOCK 10 N35E 33LKS, HEMLOCK 14 S61W 31LKS.
1972 ROWE ENG.; ROWE, P.S.#11192; SURVEY L.2 PG.433; FND 1" PIPE; NO WITS GIVEN
1972 ROWE, P.S.#11192; LCRC PG.3; 1" PIPE; S45E 17.88' NW COR WAREHOUSE, N50W 47.23' NAIL
W/CAP IN P.P., N20W 50.47' HYDRANT, S45W 46.17' NAIL W/CAP IN P.P
1973 EDMANDS ENG.; MCGINNIS, P.S.#18999; UNRECORDED SURVEY FOR VILLAGE OF CARO, JOB NO. 9174
FND 1" PIPE; SAME WITS AS 1972 LCRC ABOVE
1973 ROWE ENG.; ROWE, P.S.#11192; SURVEY L.438 PG.805-7; 1" PIPE; SAME WITS AS 1972 LCRC
1973 ROWE ENG.; ROWE, P.S.#11192; SURVEY L.441 PG.339-40; 1" PIPE; SAME WITS AS 1972 LCRC
1975 ROWE ENG.; BECK, P.S.#21559; SURVEY L.482 PG.615-6; 1" PIPE; SAME WITS AS 1972 LCRC
1977 LEACH ENG.; LEACH, P.S.#7236; SURVEY L.475 PG.756; NO OBJECT STATED; NO WITS GIVEN
1978 EDMANDS ENG.; MACDONALD, P.S.#22438; SURVEY L.488 PG.11; FND PIPE; SAME WITS AS 1972 LCRC
1981 ROWE ENG.; ROWE, P.S.#11192; SURVEY L.514 PG.644-5; 1" PIPE; SAME WITS AS 1972 LCRC
1981 ROWE ENG.; ROWE, P.S.#11192; SURVEY L.522 PG.309-10; NO OBJECT STATED; NO WITS GIVEN
1982 ROWE ENG.; BOLDT, P.S.#28405; SURVEY L.536 PG.1305-6; 1" PIPE; SAME WITS AS 1972 LCRC
1986 ROWE ENG.; OWENS, P.S.#20709; SURVEY L.561 PG. 614-5; NO OBJECT STATED; NO WIT GIVEN
1988 ROWE ENG.; OWENS, P.S.#20709; SURVEY L.588 PG.874-5; 1" PIPE; N30W 50.43' CTR HYDRANT,
N80W 37.08' BOTTLE CAP IN P.P, S20W 46.18' BOTTLE CAP IN P.P, N60E 59.69' FE COR POST
SECTION A. CONTINUED ON BACK

1995 ROWE ENG.; FIELD, P.S.#37276; FND 1" PIPE IN AT C/L ALMER STREET; RECOVERED 2 PREVIOUS
WITS INDICATING THAT PIPE IS IN SAME POSITION AS 1972 PIPE CITED ABOVE
FND. 1" SQUARE IRON ROD IN CONC. BELOW FND. PIPE
ACCEPTED FND PIPE AS BEST EVIDENCE OF ORIGINAL CORNER POSITION

H-3 SET STANDARD REMON MONUMENT IN MON BOX STAMPED CAP "H 3 T12N-R9E"
N67°E, 59.69' CENTER OF FENCE CORNER POST PLACED MON. BOX OVER MONUMENT
S26°W, 46.18' FND. NAIL W/ BOTTLE CAP IN N. FACE P. POLE
N64°W, 37.08' FND. NAIL W/ BOTTLE CAP IN E. FACE P. POLE
N23°W, 50.43' TOP CENTER OF HYDRANT

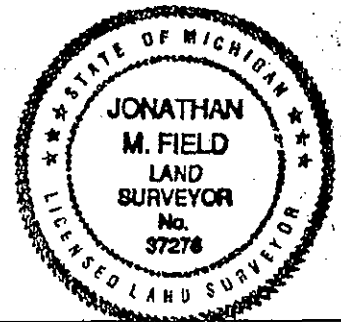

Signed by Matthias H. Fied

Date 10-27-95

Surveyor's Michigan License No. 37276

SURVEY &

1997, 1998, 1999, 2678, 26

APPROVED

10-16-45

DEC 13 1995

ACKNOWLEDGMENTS

FORM APPROVED BY MICHIGAN STATE BOARD OF LAND SURVEYORS, JAN. 28, 1971
REVISED MAY 14, 1975
REVISED JAN. 1983
ADAPTED FOR WORD PROCESSING MARCH, 1993

COPY

SECTION A. (cont.)

1988 DUNTON, P.S.#23503; SURVEY L.587 PG.80-1; NO OBJECT STATED; NO WITS GIVEN

1988 DUNTON, P.S.#23503; SURVEY L.587 PG.84-5; NO OBJECT STATED; NO WITS GIVEN

1988 ROWE ENG.; OWENS, P.S.#20709; SURVEY L.589 PG.338; FND 1" PIPE; SAME WITS AS 1988 REI SURVEY ABOVE

1988 SZYSZKOSKI, P.S.#33986; LCRC PG.58; FND 1" PIPE; N30W 50.43' TOP CTR HYDRANT, N80W 37.08' FND BOTTLE CAP IN SE FACE P.P, S20W 46.18' FND BOTTLE CAP IN N FACE P.POLE, N60E 59.69' FE COR POST

1989 ROWE ENG.; SZYSZKOSKI, P.S.#33986; SURVEY L.594 PG.890-1; FND 1" PIPE; SAME WITS AS 1988 REI SURVEY ABOVE EXCEPT N60E 39.69' FE COR POST (APPARENT TYPOGRAPHICAL ERROR IN THIS DISTANCE SINCE PREVIOUS AND SUBSEQUENT WORK SHOW DIST. TO BE 59.69')

1990 ROWE ENG.; BROWN, P.S.#33134; SURVEY L.610 PG.1347-9; FND 1" PIPE; SAME WITS AS 1988 REI SURVEY ABOVE

1992 ROWE ENG.; FIELD, P.S.#37276; SURVEY L.640 PG.997-8; FND 1" PIPE; SAME WITS AS 1988 REI SURVEY ABOVE

1992 WADE-TRIM; MCGINNIS, P.S.#18999; SURVEY L.652 PG.1373-4; NO OBJECT STATED; NO WITS GIVEN

