

1996 REMONUMENTATION PROGRAM
LAND CORNER RECORDATION CERTIFICATE

Filing Requirement of Act 74, Mich. P.A. 1970

RECEIVED FOR RECORD

LIBER NO. _____ PAGE NO. 57
FILE NO. Gilford

For corners in GILFORD TWP.

TUSCOLA
(County)

Located In:

Corner Code #

96 DEC 10 AM 8:56

Jonathan M. Field

TUSCOLA COUNTY
REGISTER OF DEEDS

Register of Deeds Stamp & File Number

1. Public Land Survey T 13N R 07E M-3 ✓
T _____ R _____
T 13N R 8E A-3
T _____ R _____
2. Property Controlling S _____ T _____ R _____
in Section S _____ T _____ R _____
3. Miscellaneous S _____ T _____ R _____
Property in Sec. S _____ T _____ R _____

4. Lot No. _____, Recorded Plat _____
5. Private Claims _____

I, JONATHAN M. FIELD, in a field survey on MAY 17 19 96, do hereby certify that under requirements of P.A. 74, Michigan P.A. of 1970, the corner points mentioned in lines 1 and 2 above were in conformance with regulations and rules therefore as required in the current manual of survey instructions of the United States Department of the Interior, Bureau of Land Management or by a decree of a Court of Law and/or that the corner points mentioned in lines 3, 4 and 5 above were in conformance with the rules of the Michigan Board of Land Surveyors or by a Decree of a Court of Law; established, re-established, monumented, re-monumented, recovered, found as expressed below:

NOTE: Not more than 4 corners, all in the same town and range, may be recorded on this certificate.

	A	B	C	D	E	F	G	H	I	J	K	L	M
1													
2	6	5	4	3	2	1							
3													
4	7	8	9	10	11	12							
5													
6	18	17	16	15	14	13							
7													
8	19	20	21	22	23	24							
9													
10	30	29	28	27	26	25							
11													
12	31	32	33	34	35	36							
13													

- A. Description of original monument and accessories and/or subsequent restoration:
1834 GLO; RISDON, D.S.; SET POST; B. OAK 12 N49W 11LK8, SUGAR 10 S27W 44LK8
1869 CRANSTON, C.S.; SURVEY OF W. 1/2 OF SEC.12, T13N-R7E; NO OBJECT STATED; NO WITS GIVEN

GLO NOTES FOR T13N-R8E INDICATE THAT THIS CORNER IS COMMON WITH A-3 T13N-R8E

- B. Description of corner evidence found and/or method applied in restoring or reestablishing corner:
1996 ROWE ENG.; FIELD, P.S.#37276; FND. 2" PIPE IN MON BOX 13' E. OF C/L ASPH. ROAD N-S & 1'S
OF C/L ASPH. ROAD E-W.

ACCEPTED FND. PIPE IN MON BOX AS BEST EVIDENCE OF ORIGINAL CORNER POSITION


- C. Description of monument for corner and accessories established to perpetuate locating the position of the corner:
M-3 SET 5/8" ROD W/STANDARD REMON CAP "STAMPED M 3 T13N R7E" INSIDE 2" PIPE, ENCASED ROD & PIPE IN CONC. IN MON. BOX

N30°E 58.30' SET P-K NAIL W/TAG #37276 IN SE FACE P. POLE
S40°E 65.10' SET P-K NAIL W/TAG #37276 IN W. FACE P. POLE
S50°W 59.65' CENTER OF ROAD SIGN POST
N60°W 64.05' TOP CENTER OF PHONE RISER
WEST 13.1' C/L PVMNT.

Signed by Jonathan M. Field Date 11-6-96
Surveyor's Michigan License No. 37276

APPROVED

11-6-96

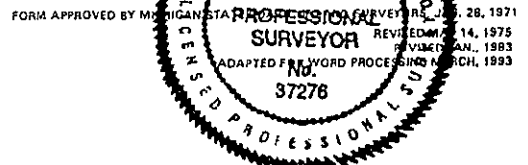



SEC. 12
T13N-R7E

M-4

180°00'00"

1996 REI 2631.69'
1834 GLO 2640'

A-4

VASSAR ROAD

SEC. 1
T13N-R7E

M-2

180°00'00"

1996 REI 2637.39'
1834 GLO 2640'

A-2

VASSAR ROAD

SEC. 7
T13N-R8E

SEC. 6
T13N-R8E

M-3

179°58'58"

A-3