

SURVEY & REMONUMENTATION

MAR 05 1998

COPY

RECEIVED FOR RECORD LIBER NO. PAGE NO. #52

SECTION

1997 REMONUMENTATION PROGRAM LAND CORNER RECORDATION CERTIFICATE Filing Requirement of Act 74, Mich. P.A. 1970

FILE NO. ELLINGTON TWP. 97 NOV 25 PM 3:46

For corners in Ellington Township

Table with columns: Tuscola (County), Located In, Corner Code #. Rows include Public Land Survey, Property Controlling in Section, and Miscellaneous Property in Sec.

Register of Deeds Stamp & File Number

TUSCOLA COUNTY REGISTER OF DEEDS

4. Lot No. Recorded Plat 5. Private Claims

I, Kenneth D. Dunton in a field survey on Oct. 10, 1997 do hereby state that under requirements of P.A. 74, Michigan P.A. of 1970, the corner points mentioned in lines 1 and 2 above were in conformance with regulations and rules therefore as required in the current manual of survey instructions of the United States Department of the Interior, Bureau of Land Management or by a decree of a Court of Law and /or that the corner points mentioned in lines 3, 4 and 5 above were in conformance with the rules of the Michigan Board of Land Surveyors or by a Decree of a Court of Law; established, re-established, monumented, recovered, found as expressed below:

Grid table with columns A-M and rows 1-12 for recording corner points.

NOTE: Not more than 2 corners, all in the same town and range, may be recorded on this certificate.

A. Description of original monument and accessories and/or subsequent restoration:

Nov. 17, 1834 Hervey Parke, D.S. Ran the East line of T12N-R9E and at 480 chains North of SE cor. Sec. 36, T12N-R9E set a temporary post but gave no witnesses. Nov. 22, 1834 Hervey Parke, D.S. ran the South line of T13N-R10E and at 476.33 chains intersected range line 4.50 South of temporary post bearings - Pine 20" N19°E 24 links and Tamarack 9" S13 1/2°W 37 links. Dec. 26, 1834 Hervey Parke, D.S. ran the South line of T13N-R9E and began at the post corner T12 & 13N-R9 & 10E, bearings - Pine 20" N19°E 47 links, Tamarack 9" S13 1/2°W 37 links. May 2 1978, LCRC Page 18 by Rowe, L.S. #11192. Fnd. 5/8" re-rod w/top 10" bent over. Held where it goes straight.

B. Description of corner evidence found and/or method applied in restoring or reestablishing corner:


Section A con't on back of form. Found 5/8" iron rod, crockery, china, green glass and clear glass buried at site around 5/8" rod. Found one accessory that indicates the corner found is in the same position as the 1978 L.C.R.C. Accepted 5/8" iron and buried objects(noted above) as the best evidence of the original corner.

C. Description of monument for corner and accessories established to perpetuate locating the position of the corner:

Removed 5/8" iron rod and placed concrete monument with standard brass cap stamped M-13, T13N-R9E. Replaced disturbed pieces of crockery, china and glass around monument. N70°W 31.15' fnd. spike in SW face 10" Poplar. S85°W 55.75' set T.C. Remon. tag & spike in N. face of cluster of 5 - 4" to 8" Maples. N80°W 41.41' set T. C. Remon. tag & spike in N. face of cluster of 4 - 6" to 12" Maples. N40°E 42.94' set T. C. Remon. tag & spike in SE face of p. pole.

Cor. A-13, T13N-R10E is common with M-13, T13N-R9E, M-1, T12N-R9E & A-1, T12N-R10E Signed by [Signature] Date 11-24-97 Surveyor's Michigan License No. 23503

APPROVED 11-24-97 [Signatures]

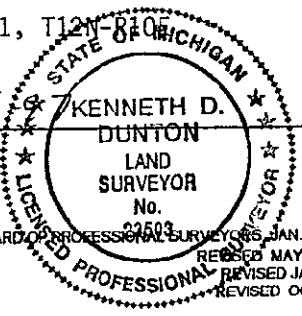

Section A con't from front of form:

S45°E 32.60' face road sign post, S60°E 78.68' RLS 11192 tag in 4" Paper Birch, N45°E 34.85' RLS 11192 tag in flimsy cor./f.p., N80°W 41.20' RLS 11192 tag in 4" Maple in clump of Maples, ?85°W 15.25' face of N. leg of sign post. Sept. 12, 1977 Survey L-478, P-482 & 483 by Beck, L.S. #21559. No mention of object found. S45°E 32.60' road sign post, S60°E 78.68' RLS 11192 tag in 4" Paper Birch, N45°E 34.85' RLS 11192 tag in cor. fence post. June 8, 1978 Survey L-488, P-884 through 886 by Dunton with Rowe Eng. No mention of object found. Accessories same as Survey L-478, P-482 & 483. June 11, 1979 Survey L-499, P-631 through 634 by Quist, L.S. #25868. Object and accessories same as Survey L-488, P-884 through 886. June 11, 1979 Survey L-500, P-452 & 453 by Beck, L.S. #21559. Same object and accessories as Survey L-499, P-631 through 634. Jan. 15, 1980 Survey L-503, P-1250 by Beck, L.S. #21559. Object and accessories same as Survey L-500, P-452 & 453. March 31, 1980 Survey L-505, P-702 & 703 by Fokens, L.S. #21567. Object and accessories same as Survey L-503, P-1250. Oct. 23, 1981 Survey L-522, P-894 & 895 by Fokens, L.S. #21567. Same object and accessories as Survey L-505, P-702 & 703.

