

FILED

NOV 15 1994

**VAN BUREN COUNTY REMONUMENTATION
LAND CORNER RECORDATION CERTIFICATE**
Filing Requirement of Act 74, Mich. P.A. 1970

SEP 21 10 47 AM '94

COMMISSION

For corners in

VAN BUREN

(County)

Located in:

Corner Code #

SOUTH QUARTER POST OF SECTION 6, ARLINGTON TOWNSHIP

- | | | | | | | |
|------------------------------------|---|---|----|----|---|-----|
| 1. Public Land Survey | T | 2 | SR | 15 | W | B-3 |
| | T | | R | | | |
| | T | | R | | | |
| | T | | R | | | |
| 2. Property Controlling in Section | S | | T | | R | |
| | S | | T | | R | |
| 3. Miscellaneous | S | | T | | R | |
| Property in Sec. | S | | T | | R | |

Mark A. Smith
VAN BUREN CO.
REGISTERED DEEDS

Register of Deeds Stamp & File Number

4. Lot No. _____, Recorded Plat _____
5. Private Claims _____

	A	B	C	D	E	F	G	H	I	J	K	L	M
2		6		5		4		3		2		1	
3													
4		7		8		9		10		11		12	
5													
6		18		17		16		15		14		13	
7													
8		19		20		21		22		23		24	
9													
10		30		29		28		27		26		25	
11													
12		31		32		33		34		35		36	
13													

I, George J. Mitchell a field surveyor on September 9, 19 94, do hereby certify that under requirements of P.A. 74, Michigan P.A. of 1970, the corner points mentioned in lines 1 and 2 above were in conformance with regulations and rules therefore as required in the current manual of survey instructions of the United States Department of the Interior, Bureau of Land Management or by a decree of a Court of Law and/or that the corner points mentioned in lines 3, 4 and 5 above were in conformance with the rules of the Michigan Board of Land Surveyors or by a Decree of a Court of Law, established, re-established, monumented, re-monumented, recovered, found as expressed below:

NOTE: Not more than 4 corners, all in the same town and range, may be recorded on this certificate.


A. Description of original monument and accessories and/or subsequent restoration:

B-3

Ratified by Peer Group in
accordance with P.A. 345 of 1990
Van Buren County Surveyor

SEE BACK OF SHEET

Date D.R.G. 9/21/94

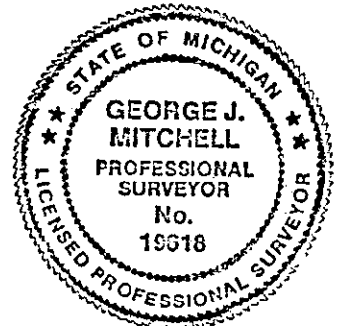

B. Description of corner evidence found and/or method applied in restoring or reestablishing corner:

B-3

FOUND RAILROAD SPIKE OVER DOUBLE CONCRETE MONUMENTS. VERIFIED CORNER LOCATION FROM RECORDED WITNESSES. SET STANDARD MONUMENT IN MONUMENT BOX

THIS GOVERNMENT MONUMENT WAS RESTORED WITH APPROVAL OF THE VAN BUREN COUNTY REMONUMENTATION PEER GROUP OF SURVEYOR'S, AND IS ACCEPTED AS A CAREFUL AND FAITHFUL PERPETUATION OF THE POSITION OF THE ORIGINAL CORNER.

C. Description of monument for corner and accessories established to perpetuate locating the position of the corner:

B-3

SET STANDARD MONUMENT IN MONUMENT BOX

NAIL & VAN BUREN CO. TAG IN WEST SIDE OF POWER POLE	NORTH 30° WEST	41.51'
NAIL & VAN BUREN CO. TAG IN SOUTH SIDE OF 30 MAPLE	NORTH 62° EAST	67.76'
NAIL & VAN BUREN CO. TAG IN NW SIDE OF POWER POLE	SOUTH 67° WEST	46.66'
NORTHWEST CORNER OF UPPER MOST CONCRETE STEP	SOUTH 16° WEST	73.44'
CENTER OF PAVEMENT ON EAST-WEST ROAD	NORTH	2.50'

Later 4 Page 145

Signed by

George J. Mitchell

Date

September 9, 1994

Surveyor's Michigan License No.

19618

SOUTH QUARTER POST OF SECTION 6
TOWN 2 SOUTH, RANGE 15 WEST, ARLINGTON TOWNSHIP

- 4/1830 - GOVERNMENT - GEORGE HARRISON, D.S.
RAN WEST BETWEEN SECTIONS 6 & 7, SET 1/4 SECTION POST AT
40.00 CHAINS.
WITNESSES - 14" BEECH - S 06° E 5 LKS. (3.30')
13" BEECH - S 15° W 34 LKS. (22.44')
- 10/1901 - W.H. GOSS, C.S.
ESTABLISHED CENTER 1/4 POST BY RUNNING RIGHT LINES
ACROSS SECTION BETWEEN 1/4 POSTS, SET TILE AT CENTER 1/4
POST.
WITNESS - 8" SUGAR - N 02° 30' E 40.5 LKS. (26.73')
- 5/15/1934 - T.A. SMITH, C.S.
FOUND DOUBLE CONCRETE MONUMENT (ONE ABOVE ANOTHER).
WITNESSES- NORTH EDGE OF SIDEWALK - SOUTH 27.25' SPIKE
IN SE SIDE OF 30" MAPLE - N40°E 43.7'
ANGLE AT 1/4 POST - SE CORNER TO SW CORNER =
179° 43'
MEASURED EAST 2643.7' TO SE COR OF SECTION.
- 10/11/1955 - W. Q. SMITH, R.L.S.
SURVEY OF PARCEL WEST OF 1/4 POST.
- 10/6/1972 - ALTON HOWARD, R.L.S.
SURVEY RECORDED (L3-P151) - IRON PIPE WITH WITNESS.
SURVEY RECORDED (L3-P153) - IRON PIPE WITH WITNESS
- 5/4/1973 - W. Q. SMITH, R.L.S.
CORNER RECORDED (L2-P37) - RAILROAD SPIKE
- 11/14/1973 - D. A. RATEKIN, R.L.S.
CORNER RECORDED (L2-P153) - RAILROAD SPIKE
- 11/29/1988 - DON R. GILCHRIST, C.S.
CORNER RECORDED (L3-P142) - RAILROAD SPIKE ON TOP OF
DOUBLE CONCRETE MONUMENT.

Label 4 Page 144