

FILED

NOV 15 1994

LIBER 4 PAGE 165 COMMISSION LAND CORNER RECORDATION CERTIFICATE OCT 18 12 03 PM '94
Filing Requirement of Act 74, Mich. P.A. 1970

For corners in Antwerp Township

Van Buren County

Located In:

Corner Code ##

S. W. (County)
~~SE~~ COR1. Public Land Survey
Section 24

T 3S R 13W

K-9

T R

T R

T R

2. Property Controlling
in Section

S T R

S T R

3. Miscellaneous
Property in Sec.

S T R

S T R

4. Lot No. , Recorded Plat

5. Private Claims

Mark A. Smith
VAN BUREN CO.
REGISTER OF DEEDS

Register of Deeds Stamp & File Number

9.00

10/18 0101 105 SURVEY

1. Donald R. Gilchrist, in a field survey on June 29, 1994, do hereby certify that under requirements of P.A. 74, Michigan P.A. of 1970, the corner points mentioned in lines 1 and 2 above were in conformance with regulations and rules therefore as required in the current manual of survey instructions of the United States Department of the Interior, Bureau of Land Management or by a decree of a Court of Law and/or that the corner points mentioned in lines 3, 4 and 5 above were in conformance with the rules of the Michigan Board of Land Surveyors or by a Decree of a Court of Law; established, re-established, monumented, re-monumented, recovered, found as expressed below:

do hereby certify that under requirements of P.A. 74, Michigan P.A. of 1970, the corner points mentioned in lines 1 and 2 above were in conformance with regulations and rules therefore as required in the current manual of survey instructions of the United States Department of the Interior, Bureau of Land Management or by a decree of a Court of Law and/or that the corner points mentioned in lines 3, 4 and 5 above were in conformance with the rules of the Michigan Board of Land Surveyors or by a Decree of a Court of Law; established, re-established, monumented, re-monumented, recovered, found as expressed below:

NOTE: Not more than 4 corners, all in the same town and range, may be recorded on this certificate.

A. Description of original monument and accessories and/or subsequent restoration:

Government Survey: Wm. Brookfield DS, set post with witness: 11" W.Oak N 74½° W 128 lk, 36" W.Oak N 4° E 96 lk. In 1968 C.D. Lawton CS noted stake: 5" hickory S 26-3/4° W 92 Lk. In 1946, T.A. Smith CS found stone down 15". In November of 1959 W.Q. Smith Cs could not find corner. He reset an iron pipe from 1" iron bar at quarter post thru RR spike at 1/8 post (1324'-1324'). He witnessed: Tripple Elm W 67.9' to C/L; 24" Hickory S 45° E 42.9' to C/L; 30" Oak N 30° E 65.2' to C/L; 3.4' E of W edge of black top.
(continued on back of Certificate)

B. Description of corner evidence found and/or method applied in restoring or reestablishing corner:

Corner approved for Remonumentation Program by Peer Group at meeting held November 25, 1992.
Corner field check by D.R. Gilchrist, County Surveyor, on June 22, 1994.

Corner re-approved at the June 29, 1994 Van Buren County Peer Group Meeting and is accepted as a careful and faithful re-establishment of the position of the Original Government Corner.

Validated by Peer Group in
accordance with P.A. 345 of 1990
Van Buren County Surveyor

Date D. R. A. 10/18/94

C. Description of monument for corner and accessories established to perpetuate locating the position of the corner:


Short Harrison Marker over 3/4" I.R.
S 20° E 37.87' nail & washer in W. face pole
S 60° W 60.40' fd. nail & washer SE face 10" Wild Cherry
N 45° W 78.90' nail in S face 14" Oak
N 50° E 47.50' C/L steel post to Stop sign

Signed by

Donald R. Gilchrist

Surveyor's Michigan License No.

Donald R. Gilchrist, RLS #11583

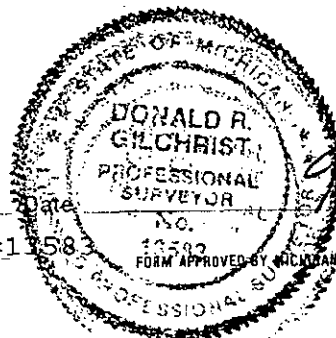

FORM APPROVED BY MICHIGAN STATE BOARD OF LAND SURVEYORS, JAN. 28, 1971
REVISED MAY 14, 1975
REVISED JAN., 1983

LIBER 4 PAGE 186

A. Continued from front of Certificate:

In 1962 witness added: Tel. pole SE 36.8'. In 1974 D.R. Gilchrist CS found 3/4" pipe & witnessed on survey. In 1979, 1981, 1982, 1984, 1991, J.C. Hunt found pipe as noted by Gilchrist & Hunt recorded corner in L. 3 p. 210. Gove Assoc. found corner in November 1989. In February & May of 1991, found 3/4" iron rod 6' S & 12' E C/L-C/L of CR 652 & 64th Avenue (this corner used by G.G. Smith for "The Vineyard" Subdivision as recorded in L. 8 p. 47). Witnessed: S 20° E 87.87' fd. nail & washer W. face pole; S 60° W 60.40' fd nail & washer SE face 10" Wild Cherry; N 45° S 78.90'' fd. nail in S. face 14" Oak; N 50° E 47.50' C/L steel post to Stop sign. Corner filed on September 13, 1991 in Liber 3 on Page 210 by J.C. Hunt.