

FEB 28 2000

Liber-30836 Page-46
99590879 12/23/1999
F.E. Youngblood, Wayne Co. Register of Deeds
RDANDSYL

SECTION

FILE DO NOT MAIL

LAND CORNER RECORDATION CERTIFICATE
Filing Requirement of Act 74, Mich. P.A. 1970

For corners in

WAYNE

(County)

Located In: CITY OF
NORTHVILLE

Corner Code #

1. Public Land Survey T 1 S R 8 E I-1
T _____ R _____
T _____ R _____
T _____ R _____
2. Property controlling S _____ T _____ R _____
in Section S _____ T _____ R _____
3. Miscellaneous S _____ T _____ R _____
Property in Sec. S _____ T _____ R _____
4. Lot No. _____, Recorded Plat _____
5. Private Claims _____

Compliance with
ACT 345, P.A. 1990

APPROVED ON: 12-7-99
WAYNE COUNTY REMONUMENTATION
PEER GROUP COMMITTEE

Register of Deeds Stamp & File Number

	A	B	C	D	E	F	G	H	I	J	K	L	M
1													
2	6	5	4	3	2	1							
3													
4	7	8	9	10	11	12							
5													
6	18	17	16	15	14	13							
7													
8	19	20	21	22	23	24							
9													
10	30	29	28	27	26	25							
11													
12	31	32	33	34	35	36							
13													

I, CHRISTOPHER S. LAMUS, in a field survey on MARCH 2, 19 99, do hereby certify that under requirements of P.A. 74, Michigan P.A. of 1970, the corner points mentioned in lines 1 and 2 above were in conformance with regulations and rules therefore as required in the current manual of survey instructions of the United States Department of the Interior, Bureau of Land Management or by decree of a Court of Law and/or that the corner points mentioned in lines 3, 4 and 5 above were in conformance with the rules of the Michigan Board of Land Surveyors or by Decree of a Court of Law; established, re-established, monumented, re-monumented, recovered, found as expressed below:

NOTE: Not more than 4 corners, all in the same town and range, may be recorded on this certificate

A. Description of original monument and accessories and/or subsequent restoration:

ORIG. GOVERNMENT NOTES 1817
WITNESSED BY FLETCHER - SET POST
S 72.5° W 14 LINKS 16' W.O. (1)
S 44° E 25 LINKS 30' W.O. (2)

NO G.L.Q. WITNESSES REMAIN

B. Description of corner evidence and/or method applied in restoring or reestablishing corner:

WAYNE CO. BUREAU OF TAXATION (1930'S)
MONUMENT (NO DESCRIPTION)
N.W. 38.06' ED. POLE (3) FOUND
S.W. 67.31' N.E. COR. LUMBER CO. (4) GONE
S.LY 61.76' 26° ELM (5) GONE
S.LY 32.21' MON. (6) FOUND
S.E. 75.19' 12° MAPLE (7) GONE
E.LY 75.23' ED. POLE (8) FOUND

PUBLIC ACT 74 L.C.R.C. L26332 P.643 (1992)
(1-1) FOUND 1/2" IRON IN MONUMENT BOX
NORTH 5.90' BACK OF CURB (11) FOUND
N 75° E 75.17' P.K. NAIL IN S. SIDE OF UTILITY
POLE (10) GONE
SOUTH 32.21' MONUMENT (12) FOUND
N 70° W 38.06' P.K. NAIL IN S. SIDE OF UTILITY
POLE (3) FOUND

WAYNE CO. ROAD COMMISSION (1970)
MONUMENT (NO DESCRIPTION)
N.W. 38.06' ED. POLE (3) FOUND
S.W. 67.23' N.E. COR. HARDWARE STORE (4) GONE
S.LY 61.75' 29° ELM (5) GONE
S.LY 32.21' MON. (6) FOUND
S.E. 46.63' 14° MAPLE (9) GONE
E.LY 75.10' ED. POLE (10) GONE


DISTANCE TO H-1 2499.99' (M) RECORDED AS 2500.21' BY WAYNE COUNTY BUREAU OF TAXATION.
DISTANCE TO I-2 2214.45' (M) RECORDED AS 2414.89' BY WAYNE COUNTY BUREAU OF TAXATION.

C. Description of monument for corner and accessories established to perpetuate locating the position of the corner:

I-1 (NOT A COMMON CORNER)
1/2" IRON ROD IN MON. BOX W/ LID.
SET BRASS W.C. WASHER AND SURVEYOR'S CAP #41914 OVER 1/2" IRON ROD IN MON BOX.
CORNER IS LOCATED IN PAVEMENT OF EIGHT MILE ROAD.
NORTH 5.90' BACK OF CURB (11)
N 81° E 75.24' SET W.C. RE-MON BRASS WASHER IN W. SIDE POWER POLE. (13)
EAST 352.79' FOUND OAKLAND CO. RE-MON P&C IN MON. BOX (SE COR 32, T1N, R8E) (14)
S 59° E 61.49' SET W.C. RE-MON BRASS WASHER IN N.E. SIDE POWER POLE. (15)
SOUTH 32.21' FOUND CONC. MON. (6)
N 75° W 38.05' SET W.C. RE-MON BRASS WASHER IN S. SIDE POWER POLE. (16)

THE SELECTED LOCATION IS ACCEPTED BY THE CONTRACTOR AND IS GENERALLY ACCEPTED BY PROFESSIONAL SURVEYORS AS THE BEST AVAILABLE EVIDENCE OF THE POSITION OF THE ORIGINAL CORNER.


Signed by

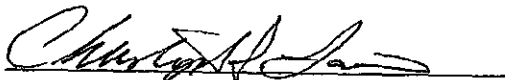

Date

12/23/99

Surveyor's Michigan License No. 41914

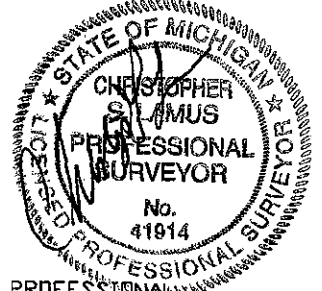

R LCR 9 4R 1Pg A. DP2