

LAND CORNER RECORDATION CERTIFICATE  
Filing Requirement of Act 74, Mich. P.A. 1970

\$ 4.00 REMONUMENTATION  
50 DEC 96 1:48 P.M. RECEIPT# 468  
RECORDED

For corners in

Wayne, Redford Twp.  
(County)

Located In: City of Detroit Corner Code #

FOREST E. YOUNGBLOOD, REGISTER OF DEEDS  
WAYNE COUNTY, MI

\$ 7.00 DEED

LI29367PA025

Compliance with  
ACT 345, P.A. 1990

APPROVED ON: 12-18-96  
WAYNE COUNTY REMONUMENTATION  
PEER GROUP COMMITTEE

Register of Deeds Stamp & File Number

1. Public Land Survey T 1S. R 10E K-4  
T R  
T R  
T R  
2. Property Controlling S T R  
in Section S T R  
3. Miscellaneous S T R  
Property in Sec. S T R

4. Lot No. , Recorded Plat  
5. Private Claims

I, William L. Roskelly, in a field survey on Dec 13, 19 96 do hereby state that under requirements of P.A. 74, Michigan P.A. of 1970, the corner points mentioned in lines 1 and 2 above were in conformance with regulations and rules therefore as required in the current manual of survey instructions of the United States Department of the Interior, Bureau of Land Management or by a decree of a Court of Law and/or that the corner points mentioned in lines 3, 4 and 5 above were in conformance with the rules of the Michigan Board of Land Surveyors or by a Decree of a Court of Law; established, re-established, monumented, recovered, found as expressed below:

NOTE: Not more than 2 corners, all in the same town and range, may be recorded on this certificate.

	A	B	C	D	E	F	G	H	I	J	K	L	M
1													
2	6		5		4		3		2		1		
3													
4	7		8		9		10		11		12		
5													
6	18		17		16		15		14		13		
7													
8	19		20		21		22		23		24		
9													
10	30		29		28		27		26		25		
11													
12	31		32		33		34		35		36		
13													

A. Description of original monument and accessories and/or subsequent restoration:

K-4) East corner section 11, T.1 S., R.10 E., Redford Township

G.L.O. (1830's) Joseph Fletcher set corner post, witnesses: Beech 10N9 W18 (gone), Ironwood 6N57 W26 (gone).  
W.P.A. (1930's) no witnesses.

No RC's or CS's found on file at Wayne County.

B. Description of corner evidence found and/or method applied in restoring or reestablishing corner:

K-4) East corner section 11, T.1 S., R.10 E., Redford Township


Found a bronze disk with punch mark in a monument box at Southfield and Curtis road, concrete.

Verified corner location by comparing City of Detroit Data with field measurements:

K-4 to K-3 Record = 2634.63' Measured = 2634.05'

K-4 to K-5 Record = 2635.39' Measured = 2636.93'

Angle line K-4 & K-3 to K-4 & K-3 Record = 180°-08'-23" Measured = 180°-08'-05"

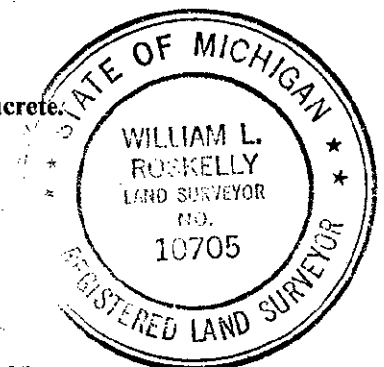

C. Description of monument for corner and accessories established to perpetuate locating the position of the corner:

K-4) East corner section 11, T.1 S., R.10 E., Redford Township

Found a bronze disk with punch mark in a monument box at Southfield and Curtis Road, concrete.

The selected location is accepted by the contractor and is generally accepted by professional surveyors as the best available evidence of the position of the corner.

WITNESSES:

Set P.K. nail and WCR tag #10705 in walk N39°-22'-40"E distance=33.93', Set P.K. nail and WCR tag #10705 in walk S44°-13'-25"E distance=36.18', Set P.K. nail and WCR tag #10705 in walk S39°-24'-14"W distance=36.56', Set P.K. nail and WCR tag #10705 in walk N43°-23'-20"W distance=33.32'

Signed by William L. Roskelly

Date 12-30-96

Surveyor's Michigan License No. 10705