

DEC 29 1998

SURVEY & REMONUMENTATION

MAR 02 1999

FILE DO NOT MAIL LAND CORNER RECORDATION CERTIFICATE Filing Requirement of Act 74, Mich. P.A. 1970

SECTION

For corners in

Wayne, Redford Twp. (County)	Located In: Detroit	Corner Code #
1. Public Land Survey	T 1 S. R 10 E	K-8
	T R	
	T R	
	T R	
2. Property Controlling in Section	S T R	
	S T R	
3. Miscellaneous Property in Sec.	S T R	
	S T R	

Compliance with ACT 345, P.A. 1990

APPROVED ON: 12-16-98 [Signature]

WAYNE COUNTY REMONUMENTATION PEER GROUP COMMITTEE

Register of Deeds Stamp & File Number

4. Lot No. _____, Recorded Plat _____

5. Private Claims _____

I, William L. Roskelly, in a field survey on Dec 11, 19 98, do hereby state that under requirements of P.A. 74, Michigan P.A. of 1970, the corner points mentioned in lines 1 and 2 above were in conformance with regulations and rules therefore as required in the current manual of survey instructions of the United States Department of the Interior, Bureau of Land Management or by a decree of a Court of Law and /or that the corner points mentioned in lines 3, 4 and 5 above were in conformance with the rules of the Michigan Board of Land Surveyors or by a Decree of a Court of Law; established, re-established, monumented, recovered, found as expressed below.

NOTE: Not more than 2 corners, all in the same town and range, may be recorded on this certificate.

1	A	B	C	D	E	F	G	H	I	J	K	L	M
2		6		5		4		3		2		1	
3													
4		7		8		9		10		11		12	
5													
6		10		17		16		15		14		13	
7													
8		19		20		21		22		23		24	
9													
10		30		29		28		27		26		25	
11													
12		31		32		33		34		35		36	
13													

A. Description of original monument and accessories and/or subsequent restoration:

K-8) East corner section 23, T.1 S., R.10 E., Redford Township, City of Detroit
 G.L.O. (1830's) Joseph Fletcher set corner, witnesses: B. Ash 12 S 84, Beech 10 N 65E 19
 W.P.A. (1930's) no witnesses.

\$7.00 DEED
 \$4.00 REMONUMENTATION
 RECORDED
 FOREST E. YOUNGBLOOD, REGISTER OF DEEDS,
 WAYNE COUNTY, MI
 Receipt #101860

B. Description of corner evidence found and/or method applied in restoring or reestablishing corner:


K-8) East corner section 23, T.1 S., R.10 E., Redford Township, City of Detroit
 Set PK nail and WCR tag Southfield and Lyndon Roads (pavement).
 Corner location re-established using occupation and Southfield Highway take from "Grandmount Sub.", L 34, P 9.
 Verified corner position by comparing City of Detroit Survey with field measurements:
 Distance K-8 to K-7 Record = 2632.82' Measured = 2632.24'
 Distance K-8 to K-9 Record = 2630.02' Measured = 2629.54'
 Angle line K-8 & K-7 to K-8 & K-9 Record = 179° 49' 21", Measured = 179° 50' 06"

C. Description of monument for corner and accessories established to perpetuate locating the position of the corner:

K-8) East corner section 23, T.1 S., R.10 E., Redford Township, City of Detroit
 Set PK nail and WCR tag at Southfield and Lyndon Roads (pavement).
 The selected location is a careful and faithful re-establishment of the position of the original corner.
 Witnesses: N14°-44'-17"E. 33.30' SE bolt light pole, S35°-09'-06"E. 71.50' top bolt hydrant, S39°-07'-58"W. 40.17' set nail and WCRC tag bridge walkway, N47°-42'-33"W. 38.46' set nail and WCRC tag bridge walkway.
 Placed Wayne County Remonumentation brass marker and stamped marker with #10705.

Signed by [Signature]
 Surveyor's Michigan License No. 10705

Date DEC 28
1998

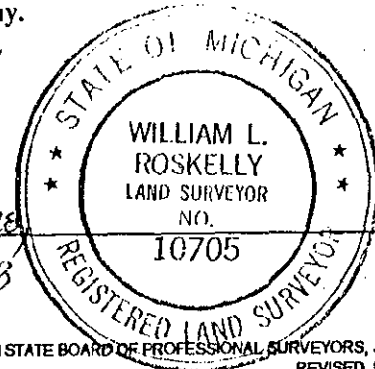

R LCR 7 4R 1PG U [Signature]

11661-30005
 Page 1 of 1
 004585651
 12/29/1998 11:53AM