

RC 1176

LAND CORNER RECORDATION CERTIFICATE
Filing Requirement of Act 74, Mich. P.A. 1970

LI 26992 PA 863

For corners in

Wayne

(County)

Located In:

City of Detroit

OTHER

Corner Code #

1. Public Land Survey

T 15 R 116

#1

T _____ R _____

T _____ R _____

T _____ R _____

2. Property Controlling
in Section

S _____ T _____ R _____

S _____ T _____ R _____

3. Miscellaneous
Property in Sec.

S _____ T _____ R _____

S _____ T _____ R _____

Compliance with
ACT 345, P.A. 1990

APPROVED ON: 11-18-93 DD
WAYNE COUNTY REMONUMENTATION
PEER GROUP COMMITTEE

Register of Deeds Stamp & File Number

4. Lot No. _____, Recorded Plat _____

5. Private Claims North line T.T.A.T. and East line Prac. Sec. 21

I, Martin C. Dunn, in a field survey on November 22, 19 93,
do hereby certify that under requirements of P.A. 74, Michigan P.A. of 1970, the corner points mentioned
in lines 1 and 2 above were in conformance with regulations and rules therefore as required in the
current manual of survey instructions of the United States Department of the Interior, Bureau of Land
Management or by a decree of a Court of Law and/or that the corner points mentioned in lines 3, 4 and 5
above were in conformance with the rules of the Michigan Board of Land Surveyors or by a Decree of a
Court of Law; established, re-established, monumented, re-monumented, recovered, found as
expressed below:

NOTE: Not more than 4 corners, all in the same town and range, may be recorded
on this certificate.

A. Description of original monument and accessories and/or subsequent restoration:

G.L.O. - Post set in original government survey by Joseph Fletcher date of contract
Sept 3, 1816.
(No original evidence found)

B. Description of corner evidence found and/or method applied in restoring or reestablishing corner:

No evidence of corner found

Reestablish corner using found irons along Livernois with reference to City of Detroit
Engineering Dept. drawing No. C4329 (dated Aug. 4, 1958) and Robert Oakmans Livernois
and Terminal Sub'n L.35, P.64.

Verified irons using sidewalk and curb splits along Livernois

Place Wayne County Remonumentation marker and plastic cap #30081 on 1/2" X 18"
iron rod in mon. box.

C. Description of monument for corner and accessories established to perpetuate locating the position of the corner:

Wayne County Remonumentation marker and plastic cap #30081 on 1/2" X 18" iron in
mon. box.

Witnesses

- Set P.K. nail with W.C.R. tag in N. face utility pole 63°AZ. - 57.55'
- Set P.K. nail with W.C.R. tag in N.E. face utility pole 135°AZ. - 70.30'
- Set P.K. nail with W.C.R. tag in asphalt walk 234°AZ. - 69.10'
- Set P.K. nail with W.C.R. tag in top of guardrail post 312°AZ. - 60.73'

The selected location is a careful and faithful reestablishment of the position of
the original corner.

Signed by

Martin C. Dunn


Date

11/30/93

Surveyor's Michigan License No.

30081

	A	B	C	D	E	F	G	H	I	J	K	L	M
2	6		5		4		3		2		1		
3													
4	7		8		9		10		11		12		
5													
6	18		17		16		15		14		13		
7													
8	19		20		21		22		23		24		
9													
10	30		29		28		27		26		25		
11													
12	31		32		33		34		35		36		
13													

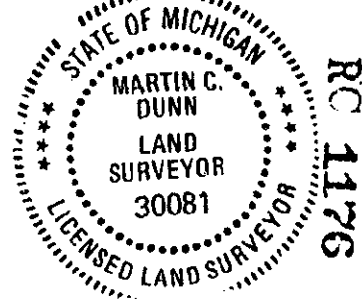

RC 1176

NOV 30 PM 4:24

FORREST COUNTY RECORDS
RECORDS SECTION
MAY 14 1975

RD
C