

STATE

RC 1196

LAND CORNER RECORDATION CERTIFICATE
Filing Requirement of Act 74, Mich. P.A. 1970

LI 26992 PA 883

For corners in

Wayne
(County)

Located In:
City of Detroit

OTHER
Corner Code #

1. Public Land Survey T 15 R 12E # 005
T _____ R _____
T _____ R _____
T _____ R _____
T _____ R _____
2. Property Controlling S _____ T _____ R _____
in Section S _____ T _____ R _____
3. Miscellaneous S _____ T _____ R _____
Property in Sec. S _____ T _____ R _____

Compliance with
ACT 345, P.A. 1990

APPROVED ON: 11-18-93 DBL
WAYNE COUNTY REMONUMENTATION
PEER GROUP COMMITTEE

Register of Deeds Stamp & File Number

4. Lot No. _____, Recorded Plat _____
5. Private Claims N.E. Cor. FC/2
On Harper between St. Antoine and Hastings

I, Martin C. Dunn, in a field survey on October 19, 19 93,
do hereby certify that under requirements of P.A. 74, Michigan P.A. of 1970, the corner points mentioned
in lines 1 and 2 above were in conformance with regulations and rules therefore as required in the
current manual of survey instructions of the United States Department of the Interior, Bureau of Land
Management or by a decree of a Court of Law and/or that the corner points mentioned in lines 3, 4 and 5
above were in conformance with the rules of the Michigan Board of Land Surveyors or by a Decree of a
Court of Law; established, re-established, monumented, re-monumented, recovered, found as
expressed below:

NOTE: Not more than 4 corners, all in the same town and range, may be recorded
on this certificate.

A. Description of original monument and accessories and/or subsequent restoration:

GLO Post - No original evidence found.

GLO original survey performed by Aaron Greely on Jan. 4, 1810.

B. Description of corner evidence found and/or method applied in restoring or reestablishing corner:

No evidence of existing corner

Found iron rods at centerline of St. Antoine @ centerline of Harper and at $\frac{1}{2}$ Hastings
@ centerline of Harper. Verified plat dimensions.

Placed Wayne County Remonumentation marker and plastic cap #30081 on 1/2" X 18" iron
within a monument box.

C. Description of monument for corner and accessories established to perpetuate locating the position of the corner:

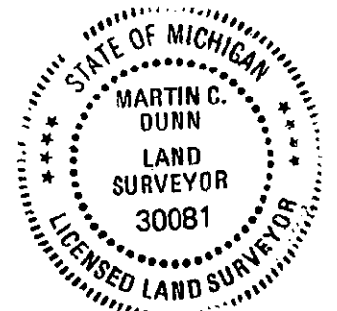
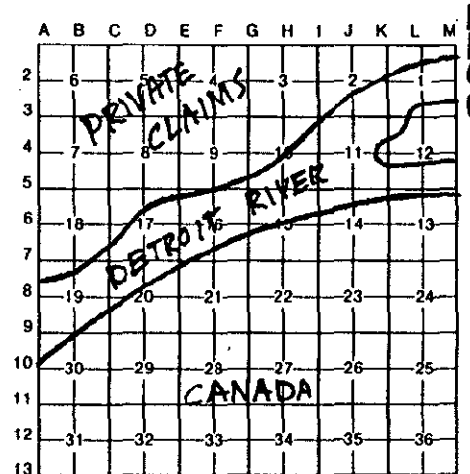
Wayne County Remonumentation marker and plastic cap #30081 on 1/2" X 18" iron within a
monument box

Witnesses

Set P.K. Nail with W.C.R. tag in stone curb
Set P.K. Nail with W.C.R. tag in stone curb
Set P.K. Nail with W.C.R. tag in stone curb
Set P.K. Nail with W.C.R. tag in stone curb

38°AZ. - 41.53'
115°AZ. - 34.01'
210°AZ. - 38.43'
300°AZ. - 32.22'

The selected location is a careful and faithful reestablishment of the position
of the original corner

Signed by Martin C. DunnDate 11/17/93Surveyor's Michigan License No. 30081

53 NOV 30 PM 4:25
FOREST COUNTY, MI
REGISTER OF DEEDS
WAYNE COUNTY, MI