

RC 1187

LI 26992 PA 874

LAND CORNER RECORDATION CERTIFICATE

Filing Requirement of Act 74, Mich. P.A. 1970

For corners in

Wayne
(County)Located In:
City of DetroitOTHER
Corner Code #

1. Public Land Survey

T 15 R 13 E# 0002

T _____ R _____

T _____ R _____

T _____ R _____

2. Property Controlling
in Section

S _____ T _____ R _____

S _____ T _____ R _____

3. Miscellaneous

S _____ T _____ R _____

Property in Sec.

S _____ T _____ R _____

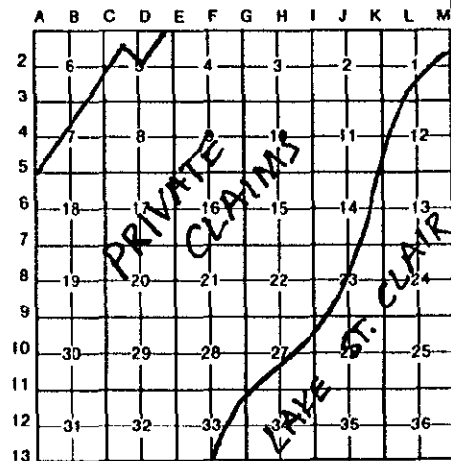
Compliance with
ACT 345, P.A. 1990APPROVED ON: 11-18-93 *DBL*
WAYNE COUNTY REMONUMENTATION
PEER GROUP COMMITTEE

Register of Deeds Stamp & File Number

4. Lot No. _____, Recorded Plat _____

5. Private Claims Point on line between, P.C. 696 and 120 on centerline Alter Rd.
± 51' North of centerline Essex Road.I, Steven E. Dunn, in a field survey on November 5, 19 93

do hereby certify that under requirements of P.A. 74, Michigan P.A. of 1970, the corner points mentioned in lines 1 and 2 above were in conformance with regulations and rules therefore as required in the current manual of survey instructions of the United States Department of the Interior, Bureau of Land Management or by a decree of a Court of Law and/or that the corner points mentioned in lines 3, 4 and 5 above were in conformance with the rules of the Michigan Board of Land Surveyors or by a Decree of a Court of Law; established, re-established, monumented, re-monumented, recovered, found as expressed below:

NOTE: Not more than 4 corners, all in the same town and range, may be recorded on this certificate.A. Description of original monument and accessories and/or subsequent restoration:
No previously recorded corner set at this location

B. Description of corner evidence found and/or method applied in restoring or reestablishing corner:

No evidence of corner

With reference to plat "Windmill Pointe Sub'n." as recorded in L.37, P.506, (W.C.R.), split back of curb of Alter Road +/- 51' North of centerline of Essex Drive, and verified distances to Ex. back of walk and Ex fence line along rear of lots facing Alter Road.

Placed Wayne County Remonumentation marker and plastic cap #28408 on 1/2" X 18" iron within monument box.

C. Description of monument for corner and accessories established to perpetuate locating the position of the corner:

Wayne County Remonumentation marker and plastic cap #28408 on 1/2" X 18" iron within monument box.

Witnesses

- Set P.K. Nail and W.C.R. witness Tag in top of conc. curb N.15°E. - 23.15'
- Set P.K. Nail and W.C.R. Witness Tag in top of conc. curb S.80°W. - 13.43'
- Set P.K. Nail and W.C.R. Witness Tag in top of conc. curb S.64°E. - 19.47'
- Set P.K. Nail and W.C.R. Witness Tag East face utility pole S.02°W. - 43.43'

The selected location for this Property Controlling Monument is accepted as a careful and faithful determination of the position as indicated.

Signed by Steven E. DunnDate Nov. 30, 1993Surveyor's Michigan License No. 28408

FOR STEVEN E. DUNN
REGISTERED IN MICHIGAN
NOV 30 PM 4:25