

RC 1530

L127797PA693

LAND CORNER RECORDATION CERTIFICATE
Filing Requirement of Act 74, Mich. P.A. 1970

For corners in

WAYNE

(County)

Located In:
CITY OF DETROIT

Corner Code #

1. Public Land Survey

T 15 R 13E020T R T R T R 2. Property Controlling
in SectionS T R S T R 3. Miscellaneous
Property in Sec.S T R S T R Compliance with
ACT 345, P.A. 1990APPROVED ON: 11-21-94
WAYNE COUNTY REMONUMENTATION
PEER GROUP COMMITTEE

Register of Deeds Stamp & File Number

4. Lot No. , Recorded Plat 5. Private Claims WEST LINE PC # 131 AND SOUTH LINE FREUD AVENUE

I, MARTIN C. DUNN, in a field survey on NOVEMBER 15, 19 94,
do hereby certify that under requirements of P.A. 74, Michigan P.A. of 1970, the corner points mentioned
in lines 1 and 2 above were in conformance with regulations and rules therefore as required in the
current manual of survey instructions of the United States Department of the Interior, Bureau of Land
Management or by a decree of a Court of Law and/or that the corner points mentioned in lines 3, 4 and 5
above were in conformance with the rules of the Michigan Board of Land Surveyors or by a Decree of a
Court of Law; established, re-established, monumented, re-monumented, recovered, found as
expressed below:

NOTE: Not more than 4 corners, all in the same town and range, may be recorded
on this certificate.

A. Description of original monument and accessories and/or subsequent restoration:

NO CORNERS SET IN ORIGINAL GOVERNMENT SURVEY



PLATS

L. 26, P. 93 "JEFFERSON PARK" MAY 4, 1910

L. 107, P. 14-22 "VICTORIA PARK - DETROIT SUBDIVISION" JUNE 13, 1994

L.C.R.C.

L. 27337 P. 560 MARTIN C. DUNN #30081 APRIL 29, 1994

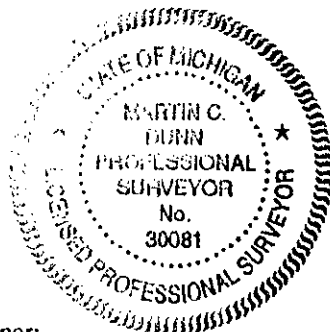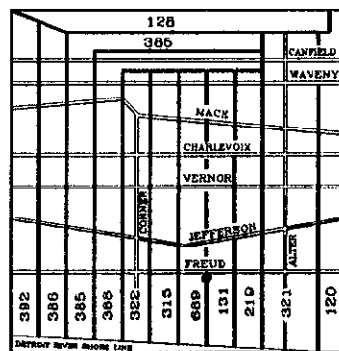

B. Description of corner evidence found and/or method applied in restoring or reestablishing corner:

FOUND PLASTIC CAP #30081 ON 1/2" REROD IN 4" DIA. x 36" LONG CONCRETE MONUMENT.

VERIFIED CORNER BY ESTABLISHING R.O.W. LINE OF JEFFERSON AVENUE USING FOUND IRONS, AND BACK OF STONE CURB AND
SIDEWALK SPLITS WITH REFERENCE TO "JEFFERSON PARK" SUBDIVISION OF THE JEFFERSON PARK REALITY COMPANY
(LIBER 26, PAGE 91, W.C.R)

\$ 13.00 MISCELLANEOUS RECORDING
27 DEC 94 10:57 A.M. RECEIPT# 47A
RECORDED
FOREST E. YOUNGBLOOD, REGISTER OF DEEDS
WAYNE COUNTY, MI

PLACED WAYNE COUNTY REMONUMENTATION MARKER AND ALUMINUM CAP ON EXISTING CONCRETE MONUMENT.

C. Description of monument for corner and accessories established to perpetuate locating the position of the corner:

WAYNE COUNTY REMONUMENTATION MARKER AND ALUMINUM CAP ON EXISTING CONCRETE MONUMENT.

WITNESSES

N. 26° E. 87.94' FOUND P.K. NAIL IN SOUTH FACE OF UTILITY POLE AT THE NORTH WEST CORNER OF FREUD AND COPLIN.

N. 61° W. 70.54' FOUND P.K. NAIL IN NORTH FACE OF UTILITY POLE ON NORTH SIDE OF FREUD - 2nd POLE WEST OF COPLIN.

S. 32° W. 45.19' FOUND "X" AT CENTERLINE OF ELECTRIC TRANSFORMER 21' S. OF S. LINE OF FREUD AND ±100 WEST OF WEST LINE COPLIN

S. 30° E. 11.70' FOUND PLASTIC CAP #30081 ON 18" IRON 6' EAST OF 3" BIRCH.

THE SELECTED LOCATION FOR THIS PROPERTY CONTROLLING MONUMENT IS ACCEPTED AS A CAREFUL AND FAITHFUL DETERMINATION
OF THE POSITION AS INDICATED.

Signed by Martin C. DunnDate 12/22/94Surveyor's Michigan License No. 30081

RC 1530