

LAND CORNER RECORDATION CERTIFICATE
Filing Requirement of Act 74, Mich. P.A. 1970

For corners in

<u>WAYNE</u> (County)	Located in: TOWNSHIP OF CANTON #07	Corner Code # I-10
1. Public Land Survey	T2S R8E	I-10
	T R	
	T R	
	T R	
2. Property Controlling in Section	S T R	
	S T R	
3. Miscellaneous Property in Sec.	S T R	
	S T R	
4. Lot No. _____, Recorded Plat _____		
5. Private Claims _____		


LIBER 29337 PAGE 55

Compliance with
 ACT 345, P.A. 1990
 APPROVED ON: 11-13-96
 WAYNE COUNTY REMONUMENTATION
 PEER GROUP COMMITTEE
 Register of Deeds Stamp & File Number

I, WALTER J. ZBIKOWSKI, in a field survey on OCTOBER 14, 1996, do hereby certify that under requirements of P.A. 75, Michigan P.A. of 1970, the corner points mentioned in lines 1 and 2 above were in conformance with regulations and rules therefore as required in the current manual of survey instructions of the United States Department of the Interior, Bureau of Land Management or by a decree of a Court of Law and/or that the corner points mentioned in lines 3, 4 and 5 above were in conformance with the rules of the Michigan Board of Land Surveyors or by a Decree of a Court of Law; established, re-established, monumented, re-monumented, recovered, found as expressed below.

A	B	C	D	E	F	G	H	I	J	K	L
2	8		5		4		3		2		1
3											
4	7		8		9		10		11		12
5											
6	18		17		16		15		14		13
7											
8	19		20		21		22		23		24
9											
10	30		29		28		27		26		25
11											
12	31		32		33		34		35		36
13											

NOTE: Not more than 4 corners, all in the same town and range, may be recorded on this certificate.

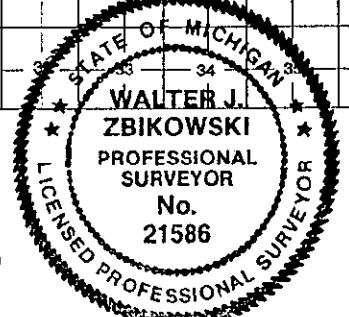

A. Description of original monument and accessories and/or subsequent restoration.
ORIGINAL GOVERNMENT SURVEY BY T. WAMPLER, D.S. (1815-1819)
 G.L.O. (1819) SET 1/2 MILE POST (DESCRIPTION OF CORNER NOT STATED IN NOTES)
 WITNESSES: IRON'D 5 S 4 E 11 (7.26' REC) (GONE)
 BEECH 13 N 38 W 20 (13.20' REC) (GONE)
RESURVEY AT THE DIRECTION OF ALBERT E. CHAMPNEY, DIRECTOR OF WAYNE COUNTY BUREAU OF TAXATION
 W.P.A. (1930s) IRON W-26 (#126)

(CONTINUED ON BACK)

B. Description of corner evidence found and/or method applied in restoring or reestablishing corner.
 FOUND A 1-1/8" IRON PIPE BURIED ONE FOOT DEEP, WEST OF CENTERLINE OF EXISTING MORTON TAYLOR ROAD (20 FEET WIDE GRAVEL/STONE ROAD) JUST SOUTH OF LANCELOT DRIVE.
 DISTANCE TO I-11 TRAVERSED AS 2654.94'; RECORD G.L.O. (1819) DISTANCE OF 40.00 CHAINS (2640.00') RECORD W.P.A. (1930s) DISTANCES OF 2655.09' AND 2654.78'
 DISTANCE TO I-9 TRAVERSED AS 2638.95'; RECORD G.L.O. (1819) DISTANCE OF 40.00 CHAINS (2640.00') RECORD W.P.A. (1930s) DISTANCES OF 2639.73' AND 2638.55')
 L.18102 P.555 IRON ROD (1972) LCRC #79
 N.20°W. 43.93' 6" OAK (GONE)
 N.70°W. 28.45' 12" OAK (GONE)
 S.45°W. 22.13' 24" OAK (GONE)

(CONTINUED ON BACK)

C. Description of monument for corner and accessories established to perpetuate locating the position of the corner.
 I-10 SECTION CORNER 26, 27 T.2S., R.8E.
 PLACED A REMONUMENTATION BRASS DISC AND PVC CAP #21586 ON 1/2" REBAR IN NEW CONCRETE MONUMENT BURI ± 6 INCHES DEEP, WEST OF CENTERLINE OF EXISTING MORTON TAYLOR ROAD (20 FOOT WIDE GRAVEL/STONE ROAD) JUST SOUTH OF LANCELOT DRIVE AND IT IS ACCEPTED AS A CAREFUL AND FAITHF PERPETUATION OF THE POSITION OF THE ORIGINAL CORNER.
 WITNESSES: N.25°40'W. 42.68' FOUND PK NAIL IN ALUMINUM DISC #34790 ON EAST SIDE OF MULTI 6" WALN
 S.73°45'W. 65.82' SET NAIL IN WCR WITNESS BRASS DISC ON NORTH SIDE OF 24" OAK
 S.82°48'E. 35.84' SET NAIL IN WCR WITNESS BRASS DISC ON NORTH SIDE TWIN 10" OAK
 N.35°01'E. 103.49' CENTER OF CORNER POST OF 4' HIGH CYCLONE FENCE TO EAST AND SOU

Signed by Walter J. Zbikowski
 WALTER J. ZBIKOWSKI
 Surveyor's Michigan License No. 21586

Date Dec. 11, 1996

416
10D
M

\$ 10.00 DEED
 12 DEC 96 2:15 P.M. RECEIPT# 62B
 RECORDED
 FOREST E. YOUNGBLOOD, REGISTER OF DEEDS
 WAYNE COUNTY, MI
 \$ 4.00 REMONUMENTATION

SECTION A (CONTINUED)

WITNESSES:	NE	29.83'	(NAIL NW/S) 12" OAK (GONE)
	SW	48.52'	(NAIL SE/S) 35" OAK (GONE)
	W	32.18'	(NAIL N/S) FENCE POST (GONE)
	NW	72.57'	(NAIL NE/S) 18" OAK (GONE)

W.C.R.C. (1972) IRON W-26 (#126)

WITNESSES:	ENE	29.83'	(OLD NAIL N/S) 12" OAK (GONE)
	ENE	29.86'	(NAIL S/S) 12" OAK (GONE)
	SSW	22.15'	(NAIL E/S) 18" TREE (GONE)
	SW	48.5±	STUMP NO NAIL (GONE)
	WNW	28.40'	(NAIL N/S) 14" TREE (GONE)
	NW	72.6±	STUMP NO NAIL (GONE)
	NNW	43.95'	(NAIL E/S) 10" TREE (GONE)

SECTION B (CONTINUED)

WADE-TRIM TIES (F.B. 1211 P.39) (NOT RECORDED) FOUND BENT 1" IRON (1988)

EAST	54.55'	PK (GONE) N/S 8" TREE (10") (MEASURED 53.89)
SE	77.00'	PK (GONE) SW/S TWIN 10" TREE (MEASURED 76.04)
SW	64.43'	PK (GONE) N/S 18" TREE (MEASURED 65.6±)
NW	98.88'	CENTER OF TOP BOLT FIRE HYDRANT (MEASURED 99.70)

FILE DO NOT MAIL