

FILE DO NOT MAIL

MAR 17 1998

LAND CORNER RECORDATION CERTIFICATE

Filing Requirement of Act 74, Mich. P.A. 1970

Liber-29739

Page-539.0

97327829LS 12/15/1997 08:44AM

SECTION For corners in

WAYNE (County)

Located in: Corner Code # TOWNSHIP OF CANTON (#07)


- 1. Public Land Survey T2S R 8E K-02
2. Property Controlling in Section S T R
3. Miscellaneous Property in Sec. S T R
4. Lot No. Recorded Plat
5. Private Claims

Compliance with ACT 345, P.A. 1990

APPROVED ON: 11-13-97 WAYNE COUNTY REMONUMENTATION PEER GROUP COMMITTEE

Register of Deeds Stamp & File Number

Grid table with columns A-M and rows 2-13. A dot is present in cell K-2.

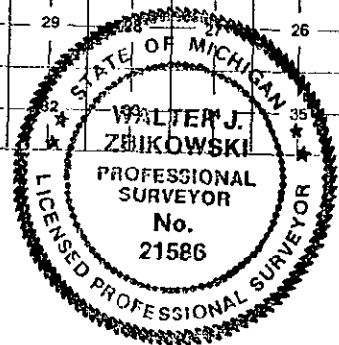

I, WALTER J. ZBIKOWSKI, in a field survey on NOVEMBER 25, 1997, do hereby certify that under requirements of P.A. 74, Michigan P.A. of 1970, the corner points mentioned in lines 1 and 2 above were in conformance with regulations and rules...

NOTE: Not more than 4 corners, all in the same town and range, may be recorded on this certificate.

A. Description of original monument and accessories and/or subsequent restoration.

ORIGINAL GOVERNMENT SURVEY BY T. WAMPLER, D.S. (1815-1819) G.L.O. (1816) NORTH BETWEEN SECS 1 & 2, 40.00 CHAINS, SET 1/2 MILE POST WITNESSES: BEECH 24" S74E 25 (LINKS) (16.50') (GONE) DO 17" S81W 29 (LINKS) (19.14') (GONE)

RESURVEY AT THE DIRECTION OF ALBERT E. CHAMPNEY, DIRECTOR OF WAYNE COUNTY BUREAU OF TAXATION

W.P.A. (1930's) IRON, W-1 (#24) WITNESSES: N 40.60' 12' ELM (GONE) SW 59.80' 30" ELM (GONE) WSW 37.96' 30" ELM (GONE)

\$4.00 REMONUMENTATION RECORDED FOREST E. YOUNGBLOOD, REGISTER OF DEEDS WAYNE COUNTY, MI Receipt #41828

B. Description of corner evidence found and/or method applied in restoring or reestablishing corner.

SET A 3/8" REBAR WITH REFERENCE PVC CAP (UNDER AN 8' HIGH CYCLONE FENCE RUNNING NORTH AND SOUTH) AT THE RECORD BEARING AND DISTANCE FROM THE NORTHWEST CORNER OF "CAPITAL INDUSTRIAL PARK" (1987) L.101 P.97 (ONE OF SIX POSSIBLE POSITION OFF KNOWN RECORDS) DISTANCE TO K-1 TRAVERSED AS 2612.19' (AS ESTABLISHED OFF MONUMENTS IN "CAPITAL INDUSTRIAL PARK") TRAVERSE DISTANCE REVISED TO 2609.05' AS RESULT OF APPROVED POSITION BY REMONUMENTATION PEER REVIEW, G.L.O. (1816) RECORD DISTANCE OF 39.31 CHAINS (2594.46'); W.P.A. (1930's) RECORD DISTANCE OF 2609.18'; "CANTON INDUSTRIAL PARK #1" (1975) L.96, P.12 AND "CANTON INDUSTRIAL PARK #2 (1984) L.100 P.96 COMBINED RECORD DISTANCE OF 2608.87'; CS# 1073 (1975) L.19018 P.271 RECORD DISTANCES OF 2609.58'; TOWNSHIP OF CANTON TAX ASSESSMENT DESCRIPTION (1997) RECORD DISTANCE OF 2607.87';

(CONTINUED ON BACK)

\$10.00 DEED

C. Description of monument for corner and accessories established to perpetuate locating the position of the corner.

K-2, SECTION CORNER 1-2, T.25., R.8E. SET A CONCRETE MONUMENT AT THE APPROVED POSITION OF THE REMONUMENTATION PEER REVIEW (UNDER A 7' HIGH CYCLONE FENCE RUNNING NORTH AND SOUTH) AT THE RECORD ANGLE OFF AN "I-275, CANTON COMMERCE PARK" SURVEY AND PRORATED WPA DISTANCE FROM SECTION CORNER K-3; THE MONUMENT FALLS APPROXIMATELY 600' EAST OF RONDA DRIVE AND 1/2 MILE SOUTH OF JOY ROAD IN A REAR YARD AND IT IS ACCEPTED AS A CAREFUL AND FAITHFUL PERPETUATION OF THE POSITION OF THE ORIGINAL CORNER. WITNESSES: S 81°57' W 28.62' SET PK NAIL IN T/C AT SOUTHWEST CORNER OF PARKING LOT ISLE N 13°47' W 16.79' SET PK NAIL IN T/C AT NORTHEAST CORNER OF PARKING LOT ISLE N 70°09' W 135.77' SOUTHEAST CORNER OF BLOCK BUILDING ADDITION (#8000 RONDA DRIVE) N 48°02' W 70.70' SET "X" CUT ON SOUTHWEST CORNER OF CATCH BASIN RIM. PLACED A REMONUMENTATION BRASS DISC AND PVC CAP #21586 ON ABOVE SET CONCRETE MONUMENT K-2.

Signed by Walter J. Zbikowski Surveyor's Michigan License No. 21586

Date DEC. 8, 1997

R-LCR-10-4R-2PG-U

B. CONTINUED

DISTANCE TO K-3 TRAVERSED AS 2641.52'; (AS ESTABLISHED OFF MONUMENTS IN "CAPITAL INDUSTRIAL PARK") TRAVERSE DISTANCE REVISED TO 2644.67' AS RESULT OF APPROVED POSITION BY REMONUMENTATION PEER REVIEW, G.L.O. (1816) RECORD DISTANCE OF 40.00 CHAINS (2640.00'); W.P.A. (1930's) RECORD DISTANCES OF 2644.71' AND 2644.77'; C.S. #765 (1973) L.19650 P.769, RECORD DISTANCE OF 2642.00'; "CAPITAL INDUSTRIAL PARK" (1987) L.101 P.97 RECORD DISTANCE OF 2639.89'; "KATY-MAR INDUSTRIAL PARK" (1988) L.102 P.71 RECORD DISTANCE OF 2645.32';

L.18650 P.767-8, FOUND 3/4" PIPE (1973) L.C.R.C. #293

WITNESSES: S 32°17' W 51.77' NAIL IN W. SIDE 28" POPLAR TREE (GONE)
S 44°15' W 27.40' NAIL IN SE SIDE 12" BEECH TREE (GONE)
N 68°17' W 4.86' NAIL IN S SIDE 18" WILD CHERRY TREE (GONE)
N 15°00' W 30.61' MSHD NAIL IN SW SIDE 14" DEAD TREE (GONE)

NOTE: SAME WITNESSES APPEAR IN L.18650 P.769, FOUND 3/4" I.P., (1973) CS #765

L.19858 P.469, FOUND 3/4" PIPE (1977) CS #1372

WITNESSES: SSW'LY 51.53' SPIKE N. SIDE 20" TREE (GONE)
W'LY 4.50' SPIKE S. SIDE 20" TREE (GONE)
NNW'LY 100.17' SPIKE E. SIDE 20" BEECH (GONE)

L.27333 P. 774, 1/2" IRON PIPE (1994) L.C.R.C. #1386

WITNESSES: NORTH 6.20' 1-1/2" X 6' STEEL FENCE POST (MEASURED 9:98' 6.75')
SOUTH 3.65' 2-1/2" X 7' STEEL FENCE POST (GONE)
S 25° W 84.56' NAIL IN 12" ASH (GONE)
N 75° W 212.92' SE COR BLOCK BLDG (MEASURED 243.49± 212.68± TO JOINT LINE OF ORIGINAL BUILDING)
N 55° W 257.20' NE COR BLOCK BLDG (MEASURED 258.83± 257.12± TO JOINT LINE OF ORIGINAL BUILDING)

NOTE: 80' HAS BEEN ADDED TO ABOVE BUILDING

SURVEY &
REMONUMENTATION

FILE DO NOT MAIL

MAR 17 1998

SECTION